

REMONUMENTATION

FEB 22 1996

GRATIOT COUNTY REMONUMENTATION PROGRAM

GRATIOT CO. MICH.

LAND CORNER RECORDATION CERTIFICATE

RECORDED

COMMISSION

Filing Requirement of Act 74, Mich. P.A. 1970

'95 DEC 20 PM 1 28

For corners in Gratiot (County)

Located In: Sumner Township

Corner Code #

Janet M. Davis REGISTER OF DEEDS

- 1. Public Land Survey Sec. 33 T 11 NR 4 W F-13 S 1/4
T R
T R
T R
2. Property Controlling in Section S T R
S T R
3. Miscellaneous Property in Sec. S T R
S T R

Register of Deeds Stamp & File Number

- 4. Lot No. Recorded Plat
5. Private Claims


Grid table with columns A-M and rows 1-13. Contains numbers 6-36.

I, William Tingley a field survey on October 15, 1993 do hereby certify that under requirements of P.A. 74, Michigan P.A. of 1970, the corner points mentioned in lines 1 and 2 above were in conformance with regulations and rules therefore as required in the current manual of survey instructions of the United States Department of the Interior, Bureau of Land Management or by a decree of a Court of Law and/or that the corner points mentioned in lines 3, 4 and 5 above were in conformance with the rules of the Michigan Board of Land Surveyors or by a Decree of a Court of Law; established, re-established, monumented, re-monumented, recovered, found as expressed below:

NOTE: Not more than 4 corners, all in the same town and range, may be recorded on this certificate.

A. Description of original monument and accessories and/or subsequent restoration:

- April 20, 1831, R. Clark, Jr., Deputy Surveyor Set quarter section post Beech 14" N68-1/2°E 41 links Beech 18" N27-1/2°W 44 links
November 28 and 29, 1892, S. S. Hastings, Deputy County Surveyor, Book C, Page 200 from Record of Minutes of Survey of Gratiot County Drain Commission Set stone deep Maple 18" N69°W 77-1/2 links Sugar 24" S85-1/4°W 13-1/4 links
March 30 and 31, 1896, W. L. Altenburg, County Surveyor, Book C, Page 219 from Record of Minutes of Survey of Gratiot County Drain Commission Set Ash Post deep 18" Maple N69°W 77-1/2 links Sugar 24" S85-1/4°W 13-1/4 links
July 2, 1981 John Nelson #21273, Liber 2 Page 28 of Land Recordation Book Found 3" bevel gear 1.0' North of Centerline of County Road 555 and 4' East of Centerline of Duffield Road North

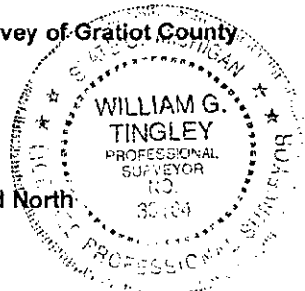

B. Description of corner evidence found and/or method applied in restoring or reestablishing corner

Found 3" bevel gear 1' North of County Road 555 and 4' East of Duffield Road North. Agrees closely with W.L. Altenburg, 1896 survey - 39.89 chains from Southeast corner, Section 33 (2632.71 by Nelson's coordinates). Also S. S. Hastings survey of 1892 shows S 1/4 Section 33 at midpoint 39.90 chains (2633.40 feet) from Southeast or Southwest Corner.

Measured by Nelson at 2634.33 feet and 2632.71 respectively. Recorded Survey, Liber 436, Page 1280-84.

C. Description of monument for corner and accessories established to perpetuate localizing the position of the corner. Set Remonumentation Corner in Monument Box in place of bevel gear.

- Pipeline marker N23°E 82 feet
Pipeline marker N65°E 56.7 feet
Nail & Tag #21273 Southeast side of Power Pole S67°W 111.31 feet
Stop Sign N10°W 57.70 feet

ACCEPTED BY THE GRATIOT COUNTY SURVEY PEER GROUP AS THE OFFICIAL CORNER UNDER MICHIGAN PUBLIC ACT 345 OF 1990 AT A MEETING HELD 11-29-95

William Tingley, PS, Chairman

This corner is accepted as a careful and faithful perpetuation of the position of the original corner.

Signed by William G. Tingley Date 12-12-95
Surveyor's Michigan License No. 30104