

**SURVEY & REMONUMENTATION**

1993

**LAND CORNER RECORDATION CERTIFICATE**

GRATIOT CO. MICH.  
RECORDED

Filing Requirement of Act 74, Mich. P.A. 1970

'93 DEC 20 PM 12 24

Gratiot County Remonumentation Program

*Janet M. Davis*  
REGISTER OF DEEDS

**COMMISSION**  
For corners in  
Gratiot \_\_\_\_\_  
(County)

Located In: \_\_\_\_\_ Corner Code # \_\_\_\_\_

- |                                    |         |                        |                    |
|------------------------------------|---------|------------------------|--------------------|
| 1. Public Land Survey              | Sec. 34 | T <u>11</u> R <u>4</u> | <u>H-13, S 1/4</u> |
|                                    |         | T _____ R _____        | _____              |
|                                    |         | T _____ R _____        | _____              |
|                                    |         | T _____ R _____        | _____              |
| 2. Property Controlling in Section | S _____ | T _____ R _____        | _____              |
|                                    | S _____ | T _____ R _____        | _____              |
| 3. Miscellaneous Property in Sec.  | S _____ | T _____ R _____        | _____              |
|                                    | S _____ | T _____ R _____        | _____              |

Register of Deeds Stamp & File Number

4. Lot No. \_\_\_\_\_, Recorded Plat \_\_\_\_\_  
5. Private Claims \_\_\_\_\_

	A	B	C	D	E	F	G	H	I	J	K	L	M
1													
2	6		5		4		3		2		1		
3													
4	7		8		9		10		11		12		
5													
6	18		17		16		15		14		13		
7													
8	19		20		21		22		23		24		
9													
10	30		29		28		27		26		25		
11													
12	31		32		33		34		35		36		
13													

I, William Tingley a field surveyor on October 15, 1993, do hereby certify that under requirements of P.A. 74, Michigan P.A. of 1970, the corner points mentioned in lines 1 and 2 above were in conformance with regulations and rules therefore as required in the current manual of survey instructions of the United States Department of the Interior, Bureau of Land Management or by a decree of a Court of Law and/or that the corner points mentioned in lines 3, 4 and 5 above were in conformance with the rules of the Michigan Board of Land Surveyors or by a Decree of a Court of Law, established, re-established, monumented, re-monumented, recovered, found as expressed below:

NOTE: Not more than 4 corners, all in the same town and range, may be recorded on this certificate.

A. Description of original monument and accessories and/or subsequent restoration:  
April 20, 1831 R. Clark, Jr. Deputy Surveyor

- Set Quarter Section Post
- Beech 7" N36-1/2°E 30 links
- Beech 9" N69°W 36 links
- January 25, 26 and 29, 1875, D.W. Altenburg, County Surveyor in Book B Page 125 of Records of Minutes of Survey in Gratiot County Drain Commission
- Old corner identified, 3 x 3 Post
- Beech 12" N54°E 65-3/4 links
- Beech 10" N21°E 86 links
- 1885 S. S. Hastings, County Surveyor, Book C Page 141 in Records of Minutes of Survey in Gratiot County Drain Commission
- Sleigh Shoe deep, Oak Post by side
- Fence line S44°
- Fence on Line 3.82 chains from Corner
- July 2, 1981, John Nelson, #21273, in Land Corner Recordation Book Gratiot County Drain Commission
- Found 3/4" Iron Pipe in Mon Box in the Centerline of Washington Road and 3' West of the Centerline of Warner Road North.


B. Description of corner evidence found and/or method applied in restoring or reestablishing corner:  
Found 3/4" Iron Pipe in Mon Box.

C. Description of monument for corner and accessories established to perpetuate locating the position of the corner:

- Set Remonumentation Corner and Mon box.
- Nail and tag Eastside of Power Pole N35°E 56.30'
- Nail and tag Eastside of Anchor Pole S34°E 46.55'
- West Road Sign Support S9°W 29.93'
- Northeast Corner Section 4, T10N R4W 5/8" Re-Rod with cap N5°W 251.78'

This corner is accepted as a careful and faithful perpetuation of the position of the original corner.

Signed by William Tingley Date 29 November 1993  
Surveyor's Michigan License No. 30104

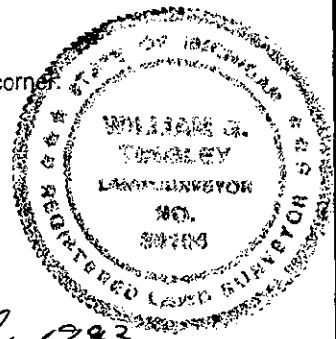

FORM APPROVED BY MICHIGAN STATE BOARD OF LAND SURVEYORS, JAN. 26, 1971  
REVISED MAY 14, 1975  
REVISED JAN., 1983  
ADAPTED FOR WORD PROCESSING MARCH, 1983