

**SURVEY & REMONUMENTATION**

SEP 08 1999

**GRATIOT COUNTY REMONUMENTATION PROGRAM  
LAND CORNER RECORDATION CERTIFICATE**  
Filing Requirement of Act 74, Mich. P.A. 1970

LIBER 563 PAGE 1121

GRATIOT CO. MICH.  
RECORDED

'96 DEC 26 AM 10:37

*Janet M. Davis*  
REGISTER OF DEEDS

**SECTION**

For corners in  
Gratiot  
(County)

Located In: Sumner

Corner Code # I-10 1/4 Corner

1. Public Land Survey	Sec <u>26</u> T <u>11N</u> R <u>4W</u>	<u>I-10 1/4 Corner</u>
	T _____ R _____	_____
	T _____ R _____	_____
	T _____ R _____	_____
2. Property Controlling in Section	S _____ T _____ R _____	_____
	S _____ T _____ R _____	_____
3. Miscellaneous Property in Sec.	S _____ T _____ R _____	_____
	S _____ T _____ R _____	_____

4. Lot No. \_\_\_\_\_ Recorded Plat \_\_\_\_\_

5. Private Claims \_\_\_\_\_

Register of Deeds Stamp & File Number


1	A	B	C	D	E	F	G	H	I	J	K	L	M
2	6	5	4	3	2	1							
3													
4	7	8	9	10	11	12							
5													
6	18	17	16	15	14	13							
7													
8	19	20	21	22	23	24							
9													
10	30	29	28	27	26	25							
11													
12	31	32	33	34	35	36							
13													

I, William Tingley a field survey on August 25 1996, do hereby certify that under requirements of P.A. 74, Michigan P.A. of 1970, the corner points mentioned in lines 1 and 2 above were in conformance with regulations and rules therefore as required in the current manual of survey instructions of the United States Department of the Interior, Bureau of Land Management or by a decree of a Court of Law and/or that the corner points mentioned in lines 3, 4 and 5 above were in conformance with the rules of the Michigan Board of Land Surveyors or by a Decree of a Court of Law, established, re-established, monumented, re-monumented, recovered, found as expressed below:

- NOTE: Not more than 4 corners, all in the same town and range, may be recorded on this certificate.
- A. Description of original monument and accessories and/or subsequent restoration:  
 1832, Orange Risdon, Deputy Surveyor, GLO Notes  
 40.00 chains; set quarter section post  
 White Ash 18" N39°E 35 links  
 Elm 14" S84°W 162 links  
 1879, T. H. Harrod, County Surveyor, Liber B, Page 279, Record of Minutes of Survey  
 Black Ash 6" x 6"  
 Black Ash 8" N67-1/2°W 2-1/2 links  
 1879, S. S. Hasting, County Surveyor, Liber C, Page 9  
 Post on North Bank of River  
 Elm 30" N22°W 95 links  
 Elm 28" N79°W 102 links  
 Donald Hunter, Survey in Section 26, 11-4  
 Corner 2637.38 feet North of Southwest Corner (Section 26) and 2643.09 feet West of Found Center 1/4.
- B. Description of corner evidence found and/or method applied in restoring or reestablishing corner:  
 Set corner by retracing Hunter's survey in section 26. - 2637.38 feet North of I-11, 11-4. (Southeast corner Section 27 and 2642.91 West of Center Section 26 in agreement with survey by Donald Hunter in Section 26.)
- C. Description of monument for corner and accessories established to perpetuate locating the position of the corner:  
 Set Standard Remonumentation Monument at base of 60" Maple stump 0.8 feet above surface of ground at  
 North Bank of Pine River.  
 Set Nail and Tag in Southside 4" Maple N80°W 6.00 feet  
 Set Nail and Tag in Northwest side 7" Elm S42°E 1.52 feet  
 Set Nail and Tag in Southside 8" Elm N84°E 8.20 feet  
 Set Nail and Tag in Southwest side 4" Twin Elm S43°W 9.44 feet  
 Northedge Pine River South 8.00 feet

This corner is a careful and faithful reestablishment of the position of the original corner.  
 Signed by William G. Tingley Date 12-7-1996  
 Surveyor's Michigan License No. 3010

ACCEPTED BY THE GRATIOT COUNTY SURVEY PEER GROUP AS THE OFFICIAL CORNER UNDER MICHIGAN PUBLIC ACT 345 OF 1990 AT A MEETING HELD 12-7-96  
W. Tingley  
 William Tingley, PS, Chairman

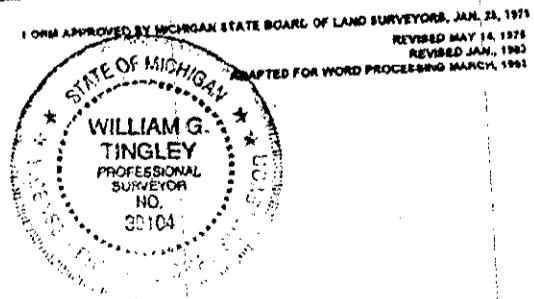

1/2 File