

FEB 22 1996

COMMISSION

GRATIOT COUNTY REMONUMENTATION PROGRAM
LAND CORNER RECORDATION CERTIFICATE
Filing Requirement of Act 74, Mich. P.A. 1970

LIBER 542 PAGE 292

GRATIOT CO. MICH.
RECORDED

'95 JAN 17 AM 11 48

For corners in
Gratiot
(County)

Located in: _____ Corner Code # _____

1. Public Land Survey Sec 30 T 12 R 4 C-10, E 1/4
 T _____ R _____
 T _____ R _____
 T _____ R _____

2. Property Controlling S _____ T _____ R _____
 in Section S _____ T _____ R _____

3. Miscellaneous S _____ T _____ R _____
 Property in Sec. S _____ T _____ R _____

4. Lot No. _____, Recorded Plat _____

5. Private Claims _____

Janet M. Davis
REGISTER OF DEEDS

Register of Deeds Stamp & File Number

I, William Tingley a field survey on August 4, 1994, do hereby certify that under requirements of P.A. 74, Michigan P.A. of 1970, the corner points mentioned in lines 1 and 2 above were in conformance with regulations and rules therefore as required in the current manual of survey instructions of the United States Department of the Interior, Bureau of Land Management or by a decree of a Court of Law and/or that the corner points mentioned in lines 3, 4 and 5 above were in conformance with the rules of the Michigan Board of Land Surveyors or by a Decree of a Court of Law; established, re-established, monumented, re-monumented, recovered, found as expressed below:

1	A	B	C	D	E	F	G	H	I	J	K	L	M
2	6	5	4	3	2	1							
3													
4	7	8	9	10	11	12							
5													
6	18	17	16	15	14	13							
7													
8	19	20	21	22	23	24							
9													
10	30	29	28	27	26	25							
11													
12	31	32	33	34	35	36							
13													

NOTE: Not more than 4 corners, all in the same town and range, may be recorded on this certificate.

A. Description of original monument and accessories and/or subsequent restoration:
1831, Orange Risdon, Dupty Surveyor, GLO Notes

Set Post

Beech 10" S41°E 29 links

White Oak 24" N46°W 28 links

November 1868, S.S. Hastings, County Surveyor, Liber B, Page 172

Old Corner, bearings good

October 1871, D.W. Attenburg, County Surveyor, Liber A, Page 280

Post 2 x 2

Pine Stump 36" S48-1/2°E 55-1/4 links

Pine Stump 30" N55°E 47-1/2 links

October 1871, D.W. Attenburg, County Surveyor, Liber b page 58

Same as Liber A, Page 280

November 1902, F.W. Hastings, Deputy County Surveyor, Liber C, Page 73

Survey of 29-12-4

Section 30-12-4, witnesses good, road graded down

Stake gone, set corner from witnesses

Gas Pipe 1-1/4" x 2", stones around

February 1906, E.W. Redman, County Surveyor, Liber D, page 78

Old Corner Found, witnesses good

ACCEPTED BY THE GRATIOT COUNTY SURVEY PEER GROUP AS THE OFFICIAL CORNER UNDER MICHIGAN PUBLIC ACT 345 OF 1990 AT A MEETING HELD Aug 5 1994

William Tingley
William Tingley, PS, Chairman

B. Description of corner evidence found and/or method applied in restoring or reestablishing corner:

Found 1-1/4" Iron Pipe -- old (has 2" of rust around it). There are 12 +/- baseball size stones around base of of pipe (everything else is sandy). Pipe has lead seam in it.

C. Description of monument for corner and accessories established to perpetuate locating the position of the corner:


Set Remonumentation Corner and Monument Box over 1-1/4" Pipe.

Found Nail Northside Power Pole N85°W 23.04 feet

Set Nail and Tag Westside 28" Red Oak S20°E 96.24 feet

Concrete Mon East 33.3 feet

Set Nail and Tag 6" Cedar Post N40°W 28.77 feet

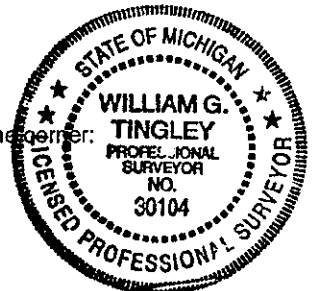

This corner is accepted as a careful and faithful perpetuation of the position of the original corner.

Signed by *William G. Tingley* Date August 5, 1994

Surveyor's Michigan License No. 30104

3/7 File