

REMONUMENTATION

GRATIOT COUNTY REMONUMENTATION PROGRAM

LIBER 542 PAGE 293

FEB 22 1996

Corner approved by Peer Group on _____, 1994

GRATIOT CO. MICH. RECORDED

COMMISSION

LAND CORNER RECORDATION CERTIFICATE '95 JAN 17 AM 11 48

Filing Requirement of Act 74, Mich. P.A. 1970

Janet M. Davis REGISTER OF DEEDS

For corners in _____ Located In: _____ Corner Code # _____
 (County)

1. Public Land Survey Sec 30 T 12 R 4 C-11, SE Corner
 T _____ R _____
 T _____ R _____
 T _____ R _____

2. Property Controlling in Section S _____ T _____ R _____
 S _____ T _____ R _____

3. Miscellaneous Property in Sec. S _____ T _____ R _____
 S _____ T _____ R _____

Register of Deeds Stamp & File Number

4. Lot No. _____, Recorded Plat _____
 5. Private Claims _____

	A	B	C	D	E	F	G	H	I	J	K	L	M
1													
2	6		5		4		3		2		1		
3													
4	7		8		9		10		11		12		
5													
6	18		17		16		15		14		13		
7													
8	19		20		21		22		23		24		
9													
10	30		29		28		27		26		25		
11													
12	31		32		33		34		35		36		
13													

I, William Tingley a field survey on August 4, 1994, do hereby certify that under requirements of P.A. 74, Michigan P.A. of 1970, the corner points mentioned in lines 1 and 2 above were in conformance with regulations and rules therefore as required in the current manual of survey instructions of the United States Department of the Interior, Bureau of Land Management or by a decree of a Court of Law and/or that the corner points mentioned in lines 3, 4 and 5 above were in conformance with the rules of the Michigan Board of Land Surveyors or by a Decree of a Court of Law; established, re-established, monumented, re-monumented, recovered, found as expressed below:


NOTE: Not more than 4 corners, all in the same town and range, may be recorded on this certificate.

A. Description of original monument and accessories and/or subsequent restoration:

1831, Orange Risdon, Deputy Surveyor, GLO Notes
 Set Post
 Beech 10" N69°E 41 links
 Beech 18" S80°W 15 links
 November 1868, S.S. Hastings, County Surveyor, Liber A, Page 116
 Pine Stump 46" N67-1/2°E 66 links
 July 1870, D.W. Attenburg, Deputy County Surveyor, Liber A, Page 190
 Post Driven Deep
 Pine Stump 40" N67-3/4°E 66 links
 Beech 12" S24-1/2°E 67-1/2 links
 October 1871, D.W. Attenburg, County Surveyor, Liber A, Page 280.
 See Letter "A", Section 32, Liber A, page 190
 October 1871, D.W. Attenburg, County Surveyor, Liber B, Page 58
 Post 2 x 2
 Witness trees omitted -- see Letter "A", Liber B, Page 71
 July 1874, D.W. Attenburg, Deputy County Surveyor, Liber A, Page 280
 Post 2 x 2
 Pine Stump 40" N67-3/4°E 66 links (old corner found)
 Beech 12" S24-1/2°E 67-1/2 links
 April 1903, F.W. Hastings, Deputy County Surveyor, Liber C, Page 72 and 73
 Old Corner Found -- 1-1/4" Gas Pipe, elbow on same
 Section 30, T12N-R4W, Witnesses good

ACCEPTED BY THE GRATIOT COUNTY SURVEY PEER GROUP AS THE OFFICIAL CORNER UNDER MICHIGAN PUBLIC ACT 345 OF 1890 AT A MEETING HELD Aug. 5, 1994

William Tingley
 William Tingley, PS, Chairman

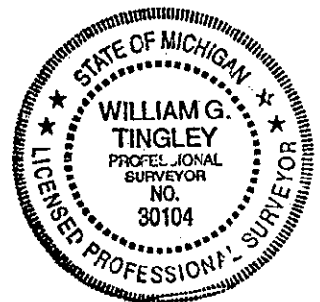

Continued on Back Page.....

B. Description of corner evidence found and/or method applied in restoring or reestablishing corner:

Found "T" Iron with cap .3 feet below surface
 "T" iron drove in hub of axle and hub, 1.7 feet long, 1-1/2" I.D.
 3.5 feet deep found 1-1/4" gas pipe with elbow per Hastings 1902
 Accepted as true corner

C. Description of monument for corner and accessories established to perpetuate locating the position of the corner:

Set Remonumentation Corner and Mon Box over 1-1/4" gas pipe
 Found Nail 24" Box Elder N60°E 52.95 feet
 Found Nail 28" Box Elder S35°E 32.14 feet
 Found Nail and Tag #30104 in Power Pole S60°W 100.13 feet
 Found PK and Tag 8" Cedar Post West 19.37 feet

This corner is accepted as a careful and faithful perpetuation of the position of the original corner.

Signed by William Tingley Date August 5, 1994
 Surveyor's Michigan License No. 30104

1/4 file

Continued for Front Page (C11-12-4)

February 1906, E.W. Redman, County Surveyor, Liber D, Page 78

Old Corner Found
 Pine Stump 40" N34°50'W 1.32-3/4 chains
 Double Elm 4" S53°25'E 98-1/4 links
 Anchor Post Fence N45°10'E 69-1/2 links

February 1906, E.W. Redman, County Surveyor, Liber C, Page 106 and 107

Old Corner Found
 Pine Stump 40" N34°50'W 1.32-3/4 chains
 Double Elm 4" S53°25'E 98-1/4 links
 Anchor Post Fence N45°10'E 69-1/2 links

April 1981, William B. Ruddell, #14769, recorded survey, Liber 436, Page 1242

Found 1" Pipe, raised with "T" Iron
 Nail and Flag in 20" Box Elder East-Northeast 53.53 feet
 Nail and Flag in 24" Box Elder Southeast 32.00 feet

[Faint, mostly illegible text, likely bleed-through from the reverse side of the page.]

[Faint, mostly illegible text at the bottom of the page, possibly bleed-through or a signature.]