


LAND CORNER RECORDATION CERTIFICATE

Filing Requirement of Act 74, Mich. PA 1970

For Corners In: <u>Grand Traverse</u> (County)	Located In _____	Corner Code # _____
1. Public Land Survey	T <u>25N</u> R <u>9W</u>	<u>K11</u>
	T _____ R _____	_____
2. Property Controlling in Section	S _____ T _____ R _____	_____
	S _____ T _____ R _____	_____
3. Miscellaneous Property in Section	S _____ T _____ R _____	_____
	S _____ T _____ R _____	_____
4. Lot No: _____	Recorded Plat: _____	
5. Private Claims: _____		

Register of Deeds Stamp & File Number

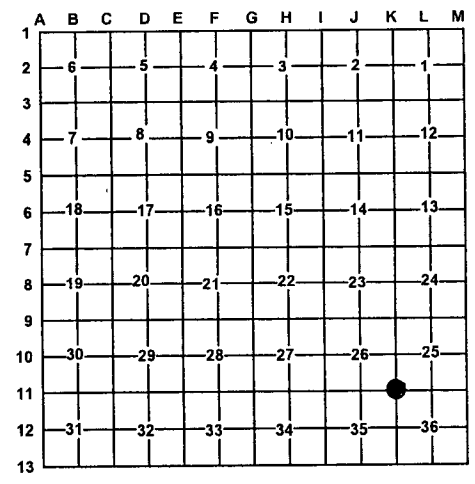

I, Craig W. McVean, in a field survey on Aug. 3, 2006 do hereby state that under requirements of PA 74, Michigan PA of 1970, the corner points mentioned in lines 1 and 2 above were in conformance with regulations and rules therefore as required in the current manual of survey instructions of the United States Department of the Interior, Bureau of Land Management or by a decree of a Court of Law and/or that the corner points mentioned in lines 3, 4 and 5 above were in conformance with the rules of the Michigan Board of Land Surveyors or by a Decree of a Court of Law; established, re-established, monumented, recovered, found as expressed below:

NOTE: Not more than 2 corners, all in the same town and range, may be recorded on this certificate.

A. Description of original monument and accessories and/or subsequent restoration:

- | | |
|--|---|
| <p><u>K11</u> – 1852 – GLO – Set Post – V. W. Caukin
 Hemlock 12" N78°E 10 L.
 Hemlock 24" S60°W 40 L.
 - 1895 – CSR – L. 1, p. 9 & 426 - Geo. Steele -
 Fd. 3 stakes in the ground and all touching each other. Wm. Slawson put down one, from original Gov't trees. I replaced w/ 'T' rail 40" long, set deep in road.
 - 1912 – CSR – L. 1, p. 495 – R. R. iron – E. P. Waterman
 - 1914 – M. Schaaf index – corner located and marked stakes stuck
 - 1969 – DNR Cor. Rec. – C.F. Roser - Fd. RR iron on end</p> | <p>flush, at intersection of trail road E-W-S. Fit Geo. Steel Survey data of Sec. 25. 18" Tam. N2°E 188.3'; 10" Tw. Oak S38°W 93.1'; Set Cedar Post N. 33'.
 - 1982 – LCRC – L. 2, p. 492 – J. L. Wilcox – Fd. R.R. iron 3' South of E-W centerline and E. side of road to South; S40°W 94.29' Fd. nail in 16" Tw. Oak; S47°E 64.05' 6" Apple; N5°W 33.14' Corner fence post; S57°W 31.67' Horse Hike Trail Post.</p> |
|--|---|

B. Description of corner evidence found and/or method applied in restoring or re-establishing corner:

K11 – Section Cor. common to Sec. 25, 26, 35 & 36 – Found Vertical 4" x 4.5" x 3.3' long Railroad Track Iron – Down 0.6' – in 'T' gravel road intersection per Steele, Waterman, Roser & Wilcox. Centerline E-W Gravel is 6'± N. Centerline Gravel Rd. S. is 6' ± W. R.R. iron accepted as a careful and faithful perpetuation of the position of the original corner.

C. Description of monument for corner and accessories established to perpetuate locating the position of the corner:

K11 – Replaced RR Track iron w/ Grand Traverse Co. Remon. 3 1/4" Brass Cap on 2 1/4" I.D. x 30" long galv. iron pipe – Down 0.8' North 32.81' to fd. 1/2" rebar w/ broken cap and add Blue Carsonite Post w/ loc. tag.
 N1°E 57.08' to set N & T in W. side Game Fence Cor. – N & E
 N31°E 60.71' to set N & T in NW side 13" R. Pine
 S49°E 48.50' to set N & T in SW side 10" R. Pine
 S32°W 94.44' to set N & T in SE side 25" Tw. Oak (JLW, CFR)
 N30°W 32.89' to set N & T in SW side 18" W. Pine scribed 'XBT'



Signed by: Craig W. McVean
 Surveyor's Michigan License No.: 39088

Date: 12/13/2006