

MICHIGAN
DEPARTMENT OF CONSERVATION
FORESTRY DIVISION

LAND CORNER RECORD

T. 25 N.R. 8 & 9 W

GRAND TRAVERSE & KALKASKA COUNTY

DESCRIPTION OF CORNER Sec. corner common to sections 13 & 24, 18 & 19

CORNER MONUMENT Set Std. Dept. Mon. (buried) in line with Ent. of Fire Lane to West.


DATE MONUMENT PLACED AND WITNESSED 5-7-69

WITNESSES TO CORNER..... 7" W. Pine S 60 W 50.3'

7" W. Pine S 40 W 61.3'

Set tag on W. Pine S 70 W 38'

AND Center of N-S Gr. Road Due W 4'

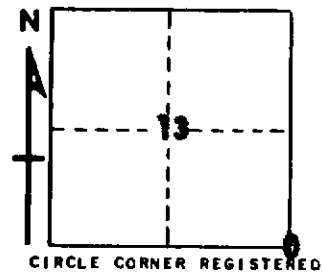

DESCRIPTION IN DETAIL AS TO HOW CORNER WAS LOCATED AND IDENTIFIED OR RESTORED.

This corner was set during retracement survey in this area. See PLAT OF SURVEY for details and land ties.

SURVEYOR'S SEAL

SIGNED Carl F. Bower DATE 5/27/69
REGISTERED LAND SURVEYOR 12028