

MICHIGAN
DEPARTMENT OF CONSERVATION
FORESTRY DIVISION

LAND CORNER RECORD

T. 25 N.R. 9 W


Grand Traverse COUNTY

DESCRIPTION OF CORNER Sec. corner common to Sections 13-14 23-24

CORNER MONUMENT Fd. 3/4" Iron Rod. Added Std. Dept. Mon.

DATE MONUMENT PLACED AND WITNESSED March 1969

WITNESSES TO CORNER..... 14" W. Pine N 19 E 112.4'

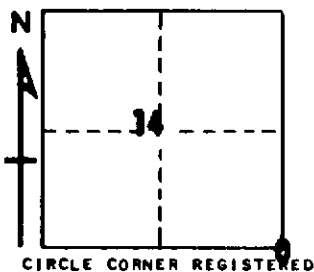

14" R. Pine S 19 W 63.5'

9" W. Pine N 44 W 87.1'
Set Cedar Post Due S 33'

AND Ctr. B.top Rd. (on curve) Due N 13'

DESCRIPTION IN DETAIL AS TO HOW CORNER WAS LOCATED AND IDENTIFIED OR RESTORED.

This corner was recovered during retracement survey in this area. F. Finnerty, RLS, Cadillac, restored this corner in the summer of 1968, from M.S.H.D. Witness, dated 1938. The corner fits the approximate center of fire lanes to the South and East. See PLAT OF SURVEY for additional info.

SURVEYOR'S SEAL

SIGNED *Carl F. Baser* DATE 5/27/69
REGISTERED LAND SURVEYOR 12028