

MICHIGAN
DEPARTMENT OF CONSERVATION
FORESTRY DIVISION

LAND CORNER RECORD

T. 25 N.R. 9 W


GRAND TRAVERSE COUNTY

DESCRIPTION OF CORNER 1/4 corner common to sections 13 & 24

CORNER MONUMENT Set Std. Dept. Mon with Cedar Guard Post.

DATE MONUMENT PLACED AND WITNESSED March 1969

WITNESSES TO CORNER..... 10" Oak S 56 W 20.5'

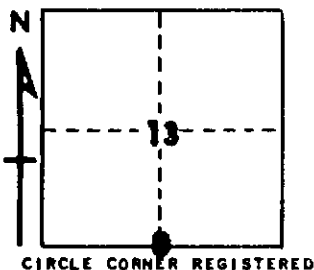

9" Oak N 13 W 72.1'

W. Pine Stump (U.S.) N 65 E 7.3'

AND
W. Pine Stump (U.S.) with S 55 W 2.0'
part of lower face intact

DESCRIPTION IN DETAIL AS TO HOW CORNER WAS LOCATED AND IDENTIFIED OR RESTORED.

This corner was restored from evidence of USBT's and calls in U.S. line notes. West edge of stream to West 390' mea., 385' U.S. Rec. West edge of lake to East, 774' mea., 771' U.S. Rec. See PLAT OF SURVEY on retracement survey in this area.

SURVEYOR'S SEAL

SIGNED

Carl F. Bauer
REGISTERED LAND SURVEYOR 12028

DATE

March 1969