

MICHIGAN
DEPARTMENT OF CONSERVATION
FORESTRY DIVISION

LAND CORNER RECORD

T. 25 N.R. 9 W


GRAND TRAVERSE COUNTY

DESCRIPTION OF CORNER SECTION CORNER COMMON TO SECTIONS 10-11-14-15

CORNER MONUMENT Fd. 2" Pipe in Conc., Schaaf Mon. Added Std. Dept. Mon. (Buried).

DATE MONUMENT PLACED AND WITNESSED 5/9/69

WITNESSES TO CORNER.....

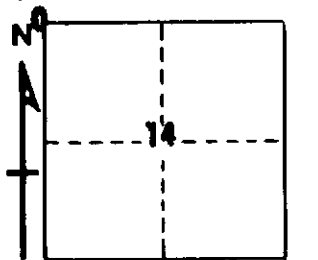

7" R. Pine S 16 E 77.2'

16" W. Pine N 14 E 96.2'

AND

Set. Cedar Post N 45 W 50'

DESCRIPTION IN DETAIL AS TO HOW CORNER WAS LOCATED AND IDENTIFIED OR RESTORED.

This corner was recovered during retracement survey in this area. Point falls in approximate center of E-W fire lane and 3 feet E or approx. center of N-S fire lane. This corner has been used by Norton & Associates, RLS, Traverse City in subdivision of Sec. 11. See PLAT OF SURVEY for additional info.

SURVEYOR'S SEAL

SIGNED

Carl F. Bauer
REGISTERED LAND SURVEYOR 12028

DATE

5/29/69