

LAND CORNER RECORDATION CERTIFICATE

Filing Requirement of Act 74, Mich. PA 1970

For Corners In:
Grand Traverse Co. Located In _____ Corner Code # _____
 (County)

- | | | | | | |
|--------------------------------------|---|-----|---|-----|-----|
| 1. Public Land Survey | T | 25N | R | 11W | H11 |
| | T | | R | | |
| 2. Property Controlling in Section | S | T | R | | |
| | S | T | R | | |
| 3. Miscellaneous Property in Section | S | T | R | | |
| | S | T | R | | |


4. Lot No: _____ Recorded Plat: _____

5. Private Claims: _____

I, Craig W. McVean, in a field survey on June 28, 2004 do hereby state that under requirements of PA 74, Michigan PA of 1970, the corner points mentioned in lines 1 and 2 above were in conformance with regulations and rules therefore as required in the current manual of survey instructions of the United States Department of the Interior, Bureau of Land Management or by a decree of a Court of Law and/or that the corner points mentioned in lines 3, 4 and 5 above were in conformance with the rules of the Michigan Board of Land Surveyors or by a Decree of a Court of Law; established, re-established, monumented, recovered, found as expressed below:

NOTE: Not more than 2 corners, all in the same town and range, may be recorded on this certificate.

Register of Deeds Stamp & File Number

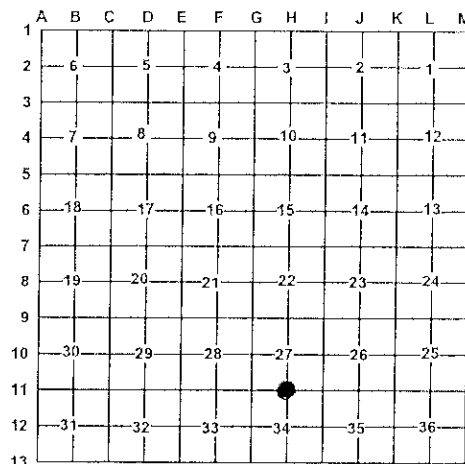

A. Description of original monument and accessories and/or subsequent restoration:

- | | |
|--|--|
| <p><u>H11</u> - GLO - Set 1/4 Post - A & A Burt - 1838
 Cedar - 12" S09°E 14'
 Cedar - 12" N30°W 31'
 Stream 6" SSW is 266' E
 - CSR L. 1, p. 122-123. H. F. Northrup - 1899±
 Found one gov't witness - set cedar stake 3" square
 Hemlock 5" N 31°W 9'
 2521' to "G11"</p> | <p>- LCRC -- L. 2, p. 53 - C. F. Roser - 1974
 Set DNR Mon. and Cedar post. Position fits stream
 Crossing tie in US notes. No other position fits.
 12" B. Cherry S 45° 32.1'
 9" Cedar N45°W 61.8'
 7" Maple N42° 18.2'
 14" Cedar stub N85°W 32.7'
 Irregular E-W fence South 11'</p> |
|--|--|

B. Description of corner evidence found and/or method applied in restoring or re-establishing corner:

H11 - 1/4 Corner common to Sections 27 & 34, T25N, R11W. Found 4" Aluminum DOC Monument 0.5' West of Cedar post. Fits three witnesses of C. F. Roser. Measured E. 266' GLO and M to stream 3' to 4' wide coarse S20°W. 4" DOC Monument accepted as the best available evidence of the position of the original corner.

C. Description of monument for corner and accessories established to perpetuate locating the position of the corner:

H11 - 4" DOC (DNR) Alum. Cap on 1" Galv. iron pipe.
 N48°W 62.07' to set N & T in Southwest side 12" Cedar (CFR)
 N42°E 18.40' to set N & T in North side 9" Red Maple (CFR)
 S42°E 32.70' to set N & T in Northeast side 14" Cherry (CFR)
 S60°E 9.49' to fnd. Nail in Southwest side twin 10" R. Maple
 S34°W 16.46' to fnd. Nail in Southeast side 9" Red Maple
 N68°W 10.48' to set N & T in Southwest Side 12" Red Maple
 Set Blue Carsonite Post 1' South



Signed by: Craig W. McVean
 Surveyor's Michigan License No.: 39088

Date: 10/25/2004