

LAND CORNER RECORDATION CERTIFICATE

FILING REQUIREMENT OF ACT 74, MICH. P.A.1970

FOR CORNERS OF--	LOCATED IN--	CORNER CODE NUMBER
1. PUBLIC LAND SURVEY	T. 25 N. R. 11 W.	I-12; J-13; K-12; K-13
2. PROPERTY CONTROLLING IN SECTION	T. _____ N. _____ S. _____ R. _____ E. _____ W. _____	
3. MISCELLANEOUS PROPERTY IN SECTION	T. _____ N. _____ S. _____ R. _____ E. _____ W. _____	
4. LOT NO. _____, RECORDED PLAT _____		
5. PRIVATE CLAIMS _____		

REGISTER OF DEEDS STAMP AND FILING NUMBER

I, Carl F. Roser do hereby certify that under requirements of P.A. 74, Michigan P.A. of 1970, the corner points mentioned in lines 1 and 2 above (identified with circles on index code diagram - over) were, in a field survey on May 21, 1974, established, re-established, monumented, re-monumented, recovered or restored as expressed below and in conformance with regulations and rules therefore as required in the current manual of survey instructions of the United States Department of the Interior, Bureau of Land Management or by a decree of a court of law. Furthermore, that the corner points mentioned in lines 3, 4 and 5 above were, in a field survey on _____ 19____, found, recovered, restored, established or re-established as expressed below and in conformance with the rules of the Michigan State Board of Registration for Land Surveyors or, by a Decree of a Court of law:

A. Description of original monument and accessories and/or subsequent restoration:

C. (continued)

K-13
Set std. Wexford Co. monument & cedar post w/loc. tag
6" Twn. Maple N54°W 16.6
5" W. Pine S05°E 53.7
9" Twn. Maple N50°E 40.1

B. Description of corner evidence found and/or method applied in restoring or re-establishing corner:

- I-12 Restored corner in N-S fence remains, midway between section corners to N and S.
- J-13 Reestablished corner per standard B.L.M. directions.
- K-12 Reestablished corner per standard B.L.M. directions.
- K-13 Due to extensive shortage to US N and S, this corner was reestablished by double proportion to US; 1 mile north, ½ mile south and 1 mile east and west.

C. Description of monument for corner and accessories established to perpetuate locating the position of the corner:

I-12	J-13	K-12
Set DNR monument & cedar post	Set std. Wexford Co. mon. & cedar post w/loc. tag	Set DNR mon. w/cedar post
4" Maple S17°E 29.2	6" Maple N06°E 22.0	7" Cherry S76°E 31.6
9" Maple S70°W 98.1	10" Maple Due W 46.5	6" Maple N12°W 22.1
8" W. Pine N33°E 76.0	11" Maple S77°E 31.4	8" Twn. Maple S68°W 15.1


SIGNED BY Carl F. Roser DATE 7-3-74

SURVEYOR'S MICHIGAN REGISTRATION NO. 12028

FOR STATE AND UNITED STATES AGENCIES:

SIGNED BY _____ CHIEF OF SURVEY PARTY DATE _____

APPROVED AND SIGNED BY _____ MICHIGAN REGISTERED LAND SURVEYOR DATE _____

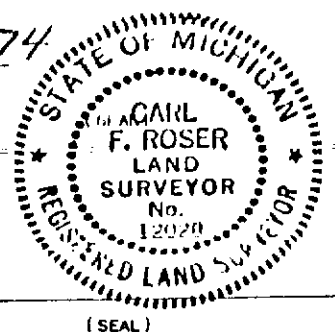

MAYFIELD TWP.
GRAND TRAVERSE COUNTY

SURVEYOR'S MICHIGAN REGISTRATION NO. _____