

LAND CORNER RECORDATION CERTIFICATE

FILING REQUIREMENT OF ACT 74, MICH. P.A.1970

FOR CORNERS OF--:	LOCATED IN--:	CORNER CODE NUMBER
1. PUBLIC LAND SURVEY_____	T. <u>25</u> N. <u>11</u> ● R. <u>11</u> ● W.	F-11; G-10; G-11
2. PROPERTY CONTROLLING IN SECTION_____	T. _____ N. <u>11</u> ● R. _____ W.	_____
3. MISCELLANEOUS PROPERTY IN SECTION_____	T. _____ N. _____ R. _____ E. _____ W.	_____
4. LOT NO. _____, RECORDED PLAT _____		
5. PRIVATE CLAIMS _____		

REGISTER OF DEEDS STAMP AND FILING NUMBER

I, Carl F. Roser do hereby certify that under requirements of P.A. 74, Michigan P.A. of 1970, the corner points mentioned in lines 1 and 2 above (identified with circles on index code diagram-over) were, in a field survey on March 25, 1974, established, re-established, monumented, re-monumented, recovered or restored as expressed below and in conformance with regulations and rules therefore as required in the current manual of survey instructions of the United States Department of the Interior, Bureau of Land Management or by a decree of a court of law. Furthermore, that the corner points mentioned in lines 3, 4 and 5 above were, in a field survey on _____ 19____, found, recovered, restored, established or re-established as expressed below and in conformance with the rules of the Michigan State Board of Registration for Land Surveyors or, by a Decree of a Court of law:

A. Description of original monument and accessories and/or subsequent restoration:

B. Description of corner evidence found and/or method applied in restoring or re-establishing corner:

- F-11 Restored corner per old surveys of record (Liber I, page 123, Nov. 1899; Liber II, page 211, 1899) which went south from $\frac{1}{4}$ corner 2,640' to set approximately center of Sec. 33. Our corner fits 2,640'± south to dirt "T" road intersection N-S-W.
- G-10 Reestablished corner on split of ROW fences E and in line with fence to S. Fit Northrup Survey of Record (1899).
- G-11 Reestablished corner per old Northrup Survey of Record (1899). Set latitude per double distance of latitude of $E\frac{1}{4}$ corner N and latitude of 1/8 line fence to N. Set departure at double distance from SW to $S\frac{1}{4}$ of Section 28.

C. Description of monument for corner and accessories established to perpetuate locating the position of the corner:

F-11	G-10	G-11
Set 1"x36" pipe buried in approx. center of N-S dirt road	Set DNR mon. (buried)	Set DNR mon. & grd. post
Set 1"x48" pipe & cedar post w/loc. tag N89°28'W 33.0	9" Maple N42°W 47.47	10" Cedar S67°W 31.8
Center conc. culvert S03°W 167	18" Maple N45°E 71.54	8" Cedar N43°W 36.5
Old irreg. fence to E Due S 42'	10" Maple S65°E 59.54	8" Cedar N45°E 32.4
Random East Due S 46.5'	Set loc. tag on corner fence post Due S 25'	9" Cedar S42°E 44.2

SIGNED BY Carl F. Roser DATE 7-4-74

SURVEYOR'S MICHIGAN REGISTRATION NO. 12028


FOR STATE AND UNITED STATES AGENCIES:

SIGNED BY _____ DATE _____

CHIEF OF SURVEY PARTY

APPROVED AND SIGNED BY _____ DATE _____

MICHIGAN REGISTERED LAND SURVEYOR

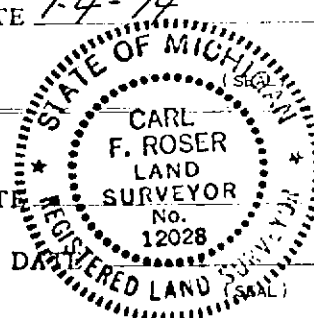

MAYFIELD Twp.
GRAND TRAVERSE COUNTY