

# LAND CORNER RECORDATION CERTIFICATE

FILING REQUIREMENT OF ACT 74, MICH. P.A.1970

FOR CORNERS OF—:	LOCATED IN—:	CORNER CODE NUMBER
1. PUBLIC LAND SURVEY _____	T. 25 <sup>N.</sup> R. 11 <sup>W.</sup>	E-12; F-12; G-12
2. PROPERTY CONTROLLING IN SECTION 33 _____	T. 25 <sup>N.</sup> R. 11 <sup>W.</sup>	8
3. MISCELLANEOUS PROPERTY IN SECTION _____	T. _____ <sup>N.</sup> <sub>S.</sub> R. _____ <sup>E.</sup> <sub>W.</sub>	
4. LOT NO. _____, RECORDED PLAT _____		
5. PRIVATE CLAIMS _____		

REGISTER OF DEEDS STAMP AND FILING NUMBER

I, Carl F. Roser do hereby certify that under requirements of P.A. 74, Michigan P.A. of 1970, the corner points mentioned in lines 1 and 2 above (identified with circles on index code diagram—over) were, in a field survey on April 1, 1974, established, re-established, monumented, re-monumented, recovered or restored as expressed below and in conformance with regulations and rules therefore as required in the current manual of survey instructions of the United States Department of the Interior, Bureau of Land Management or by a decree of a court of law. Furthermore, that the corner points mentioned in lines 3, 4 and 5 above were, in a field survey on \_\_\_\_\_ 19\_\_\_\_, found, recovered, restored, established or re-established as expressed below and in conformance with the rules of the Michigan State Board of Registration for Land Surveyors or, by a Decree of a Court of law:

~~REPRODUCTION OF THIS DOCUMENT IS PROHIBITED WITHOUT THE WRITTEN PERMISSION OF THE REGISTER OF DEEDS~~

C. (continued)

- 8
- Set 1"x36" pipe (buried)
  - 5" Maple S46°E 46.8
  - 6" Maple S13°E 46.2
  - 5" Maple N33°E 25.0
  - Set cedar post w/loc. tag
  - Due N 33'
  - Ctr. E-W dirt Rd. Due S 5.0'

B. Description of corner evidence found and/or method applied in restoring or re-establishing corner:

- E-12 Recovered pointed wood stake bottom from one old map witness NE; E. H. Allyn survey in 1906 and 1907; Liber 2, page 266.
- F-12 Established corner at intersection of ¼ lines. Corner is on center of road to N. and in line with old fence to S.
- G-12 Restored corner along side of old burnt fence post (fence remains E-W-S) believed to be a result of corner per E. P. Waterman survey; Liber 6, page 231, Dec. 1913; E.P.W. established ¼ corner from section corner to S. and U.S. line tree.


8 Established corner per standard B.L.M. instructions.

C. Description of monument for corner and accessories established to perpetuate locating the position of the corner:

E-12	F-12	G-12
Found stk. added 1½"x24" pipe (buried)	Set 1"x36" pipe	Set DNR mon. & cedar post
8" R. Pine S30°E 109.30	20" Maple N50°W 68.20	4" Thornapple S45°E 15.7
18" Maple S15°W 133.20	40" B. Chr. S06°E 82.67	No other suitable witnesses near.
36" Maple N77°E 60.10	5" R. Pine N51°E 58.20	
Fence N Due E 6'	Ctr. rd. to W Due S 20'±	
Ctr. E-W dirt Rd. Due S 6'	Set cedar post w/loc. tag	
Set cedar post w/loc. tag	Due E 33'	
Due N 33'		

SIGNED BY Carl F. Roser

DATE 7-3-74

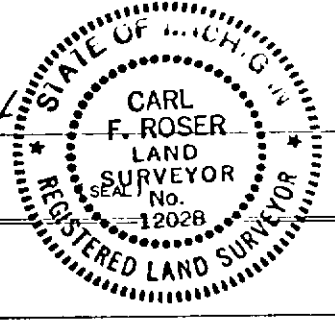

SURVEYOR'S MICHIGAN REGISTRATION NO. 12028

FOR STATE AND UNITED STATES AGENCIES:

SIGNED BY \_\_\_\_\_ DATE \_\_\_\_\_  
CHIEF OF SURVEY PARTY

APPROVED AND SIGNED BY \_\_\_\_\_ DATE \_\_\_\_\_  
MICHIGAN REGISTERED LAND SURVEYOR (SEAL)

SURVEYOR'S MICHIGAN REGISTRATION NO. \_\_\_\_\_ MAYFIELD Twp.  
GRAND TRAVERSE COUNTY