

# LAND CORNER RECORDATION CERTIFICATE

## FILING REQUIREMENT OF ACT 74, MICH. P.A.1970

FOR CORNERS OF--:	LOCATED IN--:	CORNER CODE NUMBER
1. PUBLIC LAND SURVEY _____	T. <u>25</u> N. R. <u>11</u> W. <span style="float: right;">●</span>	<u>J-10; K-10</u>
2. PROPERTY CONTROLLING IN SECTION <u>26</u>	, T. <u>25</u> N. R. <u>11</u> W. <span style="float: right;">●</span>	<u>8; 9</u>
3. MISCELLANEOUS PROPERTY IN SECTION _____	, T. _____ N. S., R. _____ E. W.	_____
4. LOT NO. _____, RECORDED PLAT _____		
5. PRIVATE CLAIMS _____		

REGISTER OF DEEDS STAMP AND FILING NUMBER

I, Carl F. Roser do hereby certify that under requirements of P.A. 74, Michigan P.A. of 1970, the corner points mentioned in lines 1 and 2 above (identified with circles on index code diagram-over) were, in a field survey on April 30, 1974, established, re-established, monumented, re-monumented, recovered or restored as expressed below and in conformance with regulations and rules therefore as required in the current manual of survey instructions of the United States Department of the Interior, Bureau of Land Management or by a decree of a court of law. Furthermore, that the corner points mentioned in lines 3, 4 and 5 above were, in a field survey on \_\_\_\_\_ 19\_\_\_\_, found, recovered, restored, established or re-established as expressed below and in conformance with the rules of the Michigan State Board of Registration for Land Surveyors or, by a Decree of a Court of law:

~~A. Description of original monument and accessories and/or subsequent restoration~~

C. (continued) 9  
 Found 1 1/4" pipe, added cedar post w/location tag  
 9" R. Pine      N22°W      12.00  
 5" R. Pine      S37°W      52.87

B. Description of corner evidence found and/or method applied in restoring or re-establishing corner:

- J-10 Recovered center of Sec. 26, at old corner fence post; fence remains E-W-S, per E. P. Waterman survey, Liber 5, pages 221 & 308, 1903±.
- K-10 Restored corner at corner concrete fence post, fence N-S-E, per E. P. Waterman survey, Liber 5, pages 217-220, 1903.
- 8 Restored corner per standard B.L.M. instructions, 1' south of fence corner (fence E-W-N) per E. P. Waterman survey, liber 5, pages 221 & 308, 1903±.
- 9 Found 1 1/4" pipe at fence corner N-S-E-W per E. P. Waterman survey, Liber 5, page 308, 1907.

C. Description of monument for corner and accessories established to perpetuate locating the position of the corner:

J-10	K-10	8
Set 1"x36" pipe & cedar post w/location tag	Set Dnr mon. on west edge of concrete fence post	Set 1"x36" pipe & cedar post w/location tag
9" Cedar      S30°E      12.3	20" Maple      N37°E      7.10	4" R. pine      N27°E      29.55
12" Cedar      S68°W      16.5	6" Maple      N22°W      36.03	5" R. pine      N75°E      20.25
6" Cedar      N47°E      8.5	12" Maple      S74°W      44.15	
Fence S-E-W	Fence remains to west (down) Due N      7'±	


SIGNED BY Carl F. Roser DATE 7-3-74

SURVEYOR'S MICHIGAN REGISTRATION NO. 12028

FOR STATE AND UNITED STATES AGENCIES:

SIGNED BY \_\_\_\_\_ DATE \_\_\_\_\_

APPROVED AND SIGNED BY \_\_\_\_\_ DATE \_\_\_\_\_

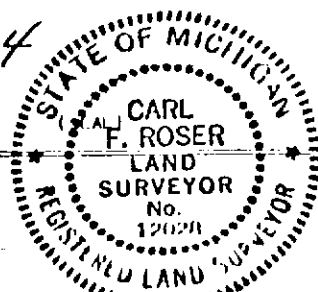

**MAYFIELD TWP.**  
**GRAND TRAVERSE COUNTY**