

LAND CORNER RECORDATION CERTIFICATE

FILING REQUIREMENT OF ACT 74, MICH. P.A.1970

| FOR CORNERS OF--: | LOCATED IN--: | CORNER CODE NUMBER |
|---------------------------------------|-------------------|--------------------|
| 1. PUBLIC LAND SURVEY | T. 25 N. R. 12 W. | A-1 |
| 2. PROPERTY CONTROLLING IN SECTION 6 | T. 25 N. R. 12 W. | 1; 2 |
| 3. MISCELLANEOUS PROPERTY IN SECTION | T. S. R. E. W. | |
| 4. LOT NO. _____, RECORDED PLAT _____ | | |
| 5. PRIVATE CLAIMS _____ | | |

REGISTER OF DEEDS STAMP AND FILING NUMBER

I, Carl F. Roser, do hereby certify that under requirements of P.A. 74, Michigan P.A. of 1970, the corner points mentioned in lines 1 and 2 above were, in a field survey on July 23, 1979, established, re-established, monumented, re-monumented, recovered or restored as expressed below and in conformance with regulations and rules therefore as required in the current manual of survey instructions of the United States Department of the Interior, Bureau of Land Management or by a decree of a court of law. Furthermore, that the corner points mentioned in lines 3, 4 and 5 above were, in a field survey on _____, 19____, found, recovered, restored, established or re-established as expressed below and in conformance with the rules of the Michigan State Board of Registration for Land Surveyors or, by a Decree of a Court of law:

A. Description of original monument and accessories and/or subsequent restoration:

B. Description of corner evidence found and/or method applied in restoring or re-establishing corner:

- A-1** Corner common to T25&26N, R12&13W, previous Dept. corner of record (1965-Shadko); see PAS #28-23, survey project #70-33. Center of blacktop road looking N is 28'± W. Corner is in line with center of blacktop road looking E.
- 1** Previous Dept. corner of record (1966-Shadko); see PAS #28-23, Survey Project #70-33.
 - 2** Previous Dept. corner of record (1966-Shadko); see PAS #28-23, Survey Project #70-33.

C. Description of monument for corner and accessories established to perpetuate locating the position of the corner:

| A-1 | 1 | 2 |
|---|--|---|
| Fd. (Dept.) Shadko mon. in mon. box near edge of bit. rd. in curve. | Fd. 1" Pipe in C E-W b'top rd. 12" Oak N25°W 125.45 | Fd. 1" pipe in C E-W b'top rd. 14" Oak S30°W 50.54 |
| 10"(Clstr. of 3)Maple N80°W 60.30 | Power Pole N39°E 74.68 | 18" Oak S10°E 36.00 |
| 5"(Clstr. of 5)Maple S20°W 42.71 | Set cedar post w/loc. tag South 33' | Fd. conc. mon. Due S 33.00 |
| 17" Twn. Cherry N70°E 86.63 | Fd. 1" pipe for W 1/8 South line Sec. 31 N89°47'W 236.13 | Fd. 1" pipe for E 1/8 South li. Sec. 31 N89°46'W 236.13 |
| Set ced. post w/loc. tag Due S. 33' | | Set cedar post w/loc. tag Due S 33' |

SIGNED BY Carl F. Roser

DATE 8-7-80

SURVEYOR'S MICHIGAN REGISTRATION NO. 12028


FOR STATE AND UNITED STATES AGENCIES:

SIGNED BY _____ DATE _____

CHIEF OF SURVEY PARTY

APPROVED AND SIGNED BY _____ DATE _____

MICHIGAN REGISTERED LAND SURVEYOR

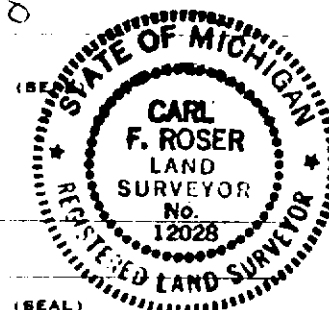

GRAND TRAVERSE COUNTY
GRANT TOWNSHIP

SURVEYOR'S MICHIGAN REGISTRATION NO. _____