

LAND CORNER RECORDATION CERTIFICATE

FILING REQUIREMENT OF ACT 74, MICH. P.A.1970

FOR CORNERS OF--:	LOCATED IN--:	CORNER CODE NUMBER
1. PUBLIC LAND SURVEY	T. 25 N. R. 12 W.	A-5; D-9
2. PROPERTY CONTROLLING IN SECTION 9	T. 25 N. R. 12 W.	12
3. MISCELLANEOUS PROPERTY IN SECTION	T. N. R. E. S., R. W.	
4. LOT NO. _____, RECORDED PLAT _____		
5. PRIVATE CLAIMS _____		

REGISTER OF DEEDS STAMP AND FILING NUMBER

I, Carl F. Roser, do hereby certify that under requirements of P.A. 74, Michigan P.A. of 1970, the corner points mentioned in lines 1 and 2 above were, in a field survey on July 18, 1979, established, re-established, monumented, re-monumented, recovered or restored as expressed below and in conformance with regulations and rules therefore as required in the current manual of survey instructions of the United States Department of the Interior, Bureau of Land Management or by a decree of a court of law. Furthermore, that the corner points mentioned in lines 3, 4 and 5 above were, in a field survey on _____, 19____, found, recovered, restored, established or re-established as expressed below and in conformance with the rules of the Michigan State Board of Registration for Land Surveyors or, by a Decree of a Court of law:

A. Description of original monument and accessories and/or subsequent restoration:

- A-5** Restored sec. cor. common to Sec. 7 & 18 (25-12) & Sec. 12 & 13 (25-13) from USBT 11" ced. stp. remains, badly decayed showing partial lower face, N58°E 12.5' & two Allyn wits. 7" ced. stp. badly decayed but showing definite lower face N6½°E 4.6' & 8" ash stp. (tree log lying E'ly), S35°E 11.2'. Allyn's survey of Sec. 18 dated Aug. 1904 in old Co. Sur. Rec. at Reg. of Deeds, L-3, pp. 308 & 309. Corner falls in wet swampy area that has been flooded as most of the ced. & ash trees are dead, but standing. Wits. with *(item C) are dead trees cut-off at 5' height & blazed & scribed.
- D-9** Fd. S¼ cor. Sec. 20 as reestab. by RLS Bill Batzer (#13026). Cor. is by old RR tie fn. post with barbed wire E-W-S.
- 12** Established 1/8 corner per standard B.L.M. instructions.

C. Description of monument for corner and accessories established to perpetuate locating the position of the corner:

A-5	D-9	12
Set DNR mon. (1"x24" pipe w/alum. cap in 1½"x84" pipe) in swamp & set cedar post w/loc. tag.	Fd. ½"x2' rerod w/RLS cap #13026; set cedar post w/loc. tag.	Drove 5/8"x40" rerod w/RLS Cap & set cedar post w/loc. tag.
*12" Ced.stub N74°E 35.1	8" Oak N83°W 26.46	10" Maple N37°W 38.5
12" Cedar S72°W 28.5	4" Oak N16°E 18.33	17" Maple S23°E 65.4
10" Maple S50°E 65.1	14" Cherry S53°W 32.09	14" Maple S60°W 60.5
*12" Ced.Stub N70°W 10.9	Ctr. E-W trl. rd. Due N 97'±	q. b.t. rd. Due S 106'±


SIGNED BY Carl F. Roser 4-8-80 DATE _____

SURVEYOR'S MICHIGAN REGISTRATION NO. 12028

FOR STATE AND UNITED STATES AGENCIES:

SIGNED BY _____ DATE _____
CHIEF OF SURVEY PARTY

APPROVED AND SIGNED BY _____ DATE _____
MICHIGAN REGISTERED LAND SURVEYOR

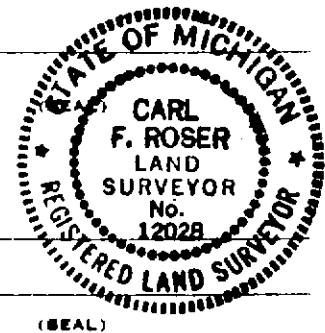

SURVEYOR'S MICHIGAN REGISTRATION NO. _____ GRAND TRAVERSE COUNTY
 GRANT TOWNSHIP