

LAND CORNER RECORDATION CERTIFICATE

FILING REQUIREMENT OF ACT 74, MICH. P.A.1970

FOR CORNERS OF--:	LOCATED IN--:	CORNER CODE NUMBER
1. PUBLIC LAND SURVEY	T. 25 N. R. 12 W.	C-5; C-6; C-7
2. PROPERTY CONTROLLING IN SECTION 17	T. 25 N. R. 12 W.	3
3. MISCELLANEOUS PROPERTY IN SECTION	T. N. R. E. S. W.	
4. LOT NO. _____, RECORDED PLAT _____		
5. PRIVATE CLAIMS _____		

REGISTER OF DEEDS STAMP AND FILING NUMBER

I, Carl F. Roser, do hereby certify that under requirements of P.A. 74, Michigan P.A. of 1970, the corner points mentioned in lines 1 and 2 above were, in a field survey on May 14, 1979, established, re-established, monumented, re-monumented, recovered or restored as expressed below and in conformance with regulations and rules therefore as required in the current manual of survey instructions of the United States Department of the Interior, Bureau of Land Management or by a decree of a court of law. Furthermore, that the corner points mentioned in lines 3, 4 and 5 above were, in a field survey on _____, 19____, found, recovered, restored, established or re-established as expressed below and in conformance with the rules of the Michigan State Board of Registration for Land Surveyors or, by a Decree of a Court of law:

~~A. Description of original monument and accessories and for subsequent restoration:~~

C. (continued)

3

Drove 1"x48" pipe w/RLS Cap & set cedar post w/loc. tag.

14" W. Pine	N56°W	16.9
14" Cedar	S49°W	13.2
14" Cedar	S22°E	16.4

B. Description of corner evidence found and/or method applied in restoring or re-establishing corner:

- C-5** Fd. old buggy iron, 24" long, that fits U.S. swamp ties ± to N & W & stream tie to W. Corner is on old fence line from E, fence mostly down.
- C-6** Fd. pipe for W $\frac{1}{4}$ corner Sec. 17 as set by K. J. Ostling (Dept. surv. 1966) at recovered stump of U.S. corner tree (y. pine 16") & one U.S.B.T. stump to NW.
- C-7** Reestablished NW corner of Sec. 20 by double proportion measure between govt. corners $\frac{1}{2}$ mile E, $\frac{1}{2}$ mile W, 1 mile S and $\frac{1}{2}$ mile N. Dept. monument as established in 1966 (in error) was moved S25°05'E 7.6' to above-noted position.
- 3** Set 1/8 corner per standard B.L.M. instructions.

C. Description of monument for corner and accessories established to perpetuate locating the position of the corner:

C-5	C-6	C-7
Fd. old buggy iron; replaced w/DNR mon. & set ced. post.	Fd. 1" pipe & cedar post; added loc. tag.	Set DNR Mon. w/cedar post.
14" W. Oak N56°E 14.89	9" W. Oak N80°W 16.3	9" TwnMaple S03°W 7.5
14" R. Maple N01°W 28.1	8" W. Oak S05°E 8.3	7"(Clstr. of 4)Maples N57°W 38.5
10" Hemlock N50°W 13.15	6" Maple N83°E 33.3	14" Oak N30°W 49.8
		E-W Random North 8'
		Random South West 5'

SIGNED BY Carl F. Roser 4-8-80

DATE _____


SURVEYOR'S MICHIGAN REGISTRATION NO. 12028

FOR STATE AND UNITED STATES AGENCIES:

SIGNED BY _____
CHIEF OF SURVEY PARTY

DATE _____

APPROVED AND SIGNED BY _____
MICHIGAN REGISTERED LAND SURVEYOR

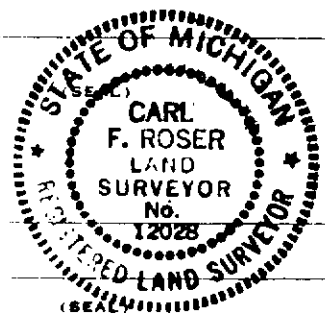

SURVEYOR'S MICHIGAN REGISTRATION NO. _____ GRAND TRAVERSE COUNTY
GRANT TOWNSHIP