

# LAND CORNER RECORDATION CERTIFICATE

## FILING REQUIREMENT OF ACT 74, MICH. P.A.1970

FOR CORNERS OF--	LOCATED IN--	CORNER CODE NUMBER
1. PUBLIC LAND SURVEY.....	T. 25 N. R. 12 W.	F-3; G-5; H-7
2. PROPERTY CONTROLLING IN SECTION 9.....	T. 25 N. R. 12 W.	9
3. MISCELLANEOUS PROPERTY IN SECTION.....	T. N. S. R. E. W.	
4. LOT NO. ...., RECORDED PLAT.....		
5. PRIVATE CLAIMS.....		

REGISTER OF DEEDS STAMP AND  
FILING NUMBER

I, Carl F. Roser, do hereby certify that under requirements of P.A. 74, Michigan P.A. of 1970, the corner points mentioned in lines 1 and 2 above were, in a field survey on August 14, 1979, established, re-established, monumented, re-monumented, recovered or restored as expressed below and in conformance with regulations and rules therefore as required in the current manual of survey instructions of the United States Department of the Interior, Bureau of Land Management or by a decree of a court of law. Furthermore, that the corner points mentioned in lines 3, 4 and 5 above were, in a field survey on \_\_\_\_\_, 19\_\_\_\_, found, recovered, restored, established or re-established as expressed below and in conformance with the rules of the Michigan State Board of Registration for Land Surveyors or, by a Decree of a Court of law:

~~A. Description of original monument and accessories and subsequent restoration:~~

C. (continued)

9  
Drove 5/8"x3' rerod w/cedar post  
and loc. tag.  
4" Maple N35°E 6.2  
13" Twin Oak S52°E 22.0  
12" Oak N82°W 13.9

B. Description of corner evidence found and/or method applied in restoring or re-establishing corner:

- F-3** Fd. pipe for N¼ cor. Sec. 9 as set by RLS firm, Gourdie-Fraser & Assoc. in 1976 survey. Fits E.P. Waterman sur. of SW¼ of Sec. 4 in 1907, L. 2-p.304 & possible USBT stump. Fd. large stone in E side of pipe; fd. E.P.W. wits. in good shape, 22" W. pine S58°E 23.6; 12" W. pine N78°W 16.3; also fd. poss. USBT W. pine 16" N80°E 6.1 (stump).
- G-5** Fd. iron (poss. gun barrel) for SE cor. Sec. 9, as noted "stake & gun barrel iron & one US wit." in E.H. Allyn 1903 & E.P. Waterman 1912 surveys.
- H-7** Fd. 1-1/8" threaded bolt in Q E-W b'top road for S¼ corner of Sec. 15.
- 9** Set 1/8 cor. per std. BLM instructions. Fd. decayed stake from 2 wits, N80°18'W 23.1', per C.P. Tuller 1920 survey (does not fit proper sec. subdivision of section).

C. Description of monument for corner and accessories established to perpetuate locating the position of the corner:

F-3	G-5	H-7
Fd. 3/8" pipe; replaced w/DNR Mon. & Cedar Post.	Fd. 3/4" oct. iron; added DNR Mon. w/Cedar Post.	Fd. 1/8" Bolt (buried 0.4').
6" R. Pine S07°E 19.30	9" Maple S68°W 11.97	34" Maple N28°E 26.80
12" Oak N42°W 26.30	8" Trpl.Oak S05°W 17.54	In Q E-W b.t. rd.
7" Oak N26°E 13.81	4" Oak N45°E 33.00	In line with fence line N & old tree line S.
	Q of E-W b.t. rd. Due S 85'±	

SIGNED BY Carl F. Roser 4-8-80 DATE \_\_\_\_\_

SURVEYOR'S MICHIGAN REGISTRATION NO. 12028


FOR STATE AND UNITED STATES AGENCIES:

SIGNED BY \_\_\_\_\_ DATE \_\_\_\_\_

CHIEF OF SURVEY PARTY

APPROVED AND SIGNED BY \_\_\_\_\_ DATE \_\_\_\_\_

MICHIGAN REGISTERED LAND SURVEYOR

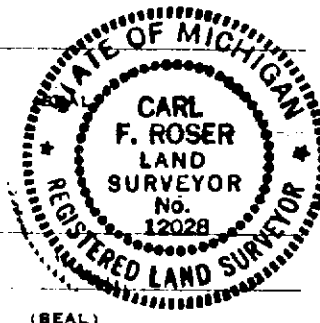

(SEAL)

SURVEYOR'S MICHIGAN REGISTRATION NO. \_\_\_\_\_ GRAND TRAVERSE COUNTY  
GRANT TOWNSHIP