

LAND CORNER RECORDATION CERTIFICATE

FILING REQUIREMENT OF ACT 74, MICH. P.A.1970

FOR CORNERS OF--:	LOCATED IN--:	CORNER CODE NUMBER
1. PUBLIC LAND SURVEY	T. 25 N. R. 12	F-4; G-4
2. PROPERTY CONTROLLING IN SECTION 20	T. 25 N. R. 12	10
3. MISCELLANEOUS PROPERTY IN SECTION 20	T. 25 N. R. 12	XX = 660' E of #2
4. LOT NO. _____, RECORDED PLAT _____		
5. PRIVATE CLAIMS _____		

REGISTER OF DEEDS STAMP AND FILING NUMBER

I, Carl F. Roser, do hereby certify that under requirements of P.A. 74, Michigan P.A. of 1970, the corner points mentioned in lines 1 and 2 above were, in a field survey on July 18, 1979, established, re-established, monumented, re-monumented, recovered or restored as expressed below and in conformance with regulations and rules therefore as required in the current manual of survey instructions of the United States Department of the Interior, Bureau of Land Management or by a decree of a court of law. Furthermore, that the corner points mentioned in lines 3, 4 and 5 above were, in a field survey on April 26, 1979, found, recovered, restored, established or re-established as expressed below and in conformance with the rules of the Michigan State Board of Registration for Land Surveyors or, by a Decree of a Court of law:

~~A - Description of original monument and accessories and/or subsequent restoration~~
 C. (continued)

XX

Drove 5/8"x36" rerod w/RLS Cap
 & set cedar post w/loc. tag.
 7" Maple N33°E 32.0
 6" Maple in clump N13°W 13.1
 9" Maple N66°W 74.8
 E-W Sand Trail Due N 64'±

F-4 B. Description of corner evidence found and/or method applied in restoring or re-establishing corner:
 Estab. ctr. of Sec. 9 at intersection of ¼ lines & drove 5/8"x40" rerod. Fd. C.P. Tuller's hub for ctr. of Sec. 9 from his pine stump wit., from his sur. of 1920. L-3, p. 403, to be N70°23'W 25.6'; did not accept Tuller stk. as it was too far out of position (no occupancy)

G-4 Fd. Gray gran. stone & one Tuller wit. for E½ Sec. 9 as set by Tuller in 1920 from fd. USBT stumps & old hole in ground of old rotted post. Tuller set 26"x14"x28" gray granite stone w/+ on top. See old Co. Sur. Rec. at Reg. of Deeds, L-3, p. 403, C. P. Tuller, April 1920.

10 Established 1/8 corner per standard B.L.M. instructions.

XX Established NW corner of E½ NE¼ NE¼ of Sec. 20 per standard B.L.M. instructions.

C. Description of monument for corner and accessories established to perpetuate locating the position of the corner:

F-4	G-4	10
Drove 5/8"x40" rerod w/RLS Cap & set ced. post w/loc. tag.	Fd. 1'x2'x2' high pointed stone w/cross & set cedar post w/loc. tag.	Drove 5/8"x30" rerod w/RLS cap & cedar post w/loc. tag.
15" R. Pine N50°W 37.4	22" Maple S14°W 41.25	6" Maple N11°E 9.9
12" Oak N52°E 28.3	7" Maple N55°W 4.02	6" Maple S73°W 16.2
10" Oak S07°E 17.1	12" Trp1.Oak N70°E 7.79	6" Maple S33°E 7.6
Old scar		N-S Trav. East 2'±


SIGNED BY Carl F. Roser 4-8-80 DATE _____

SURVEYOR'S MICHIGAN REGISTRATION NO. 12028

FOR STATE AND UNITED STATES AGENCIES:

SIGNED BY _____ DATE _____

APPROVED AND SIGNED BY _____ DATE _____

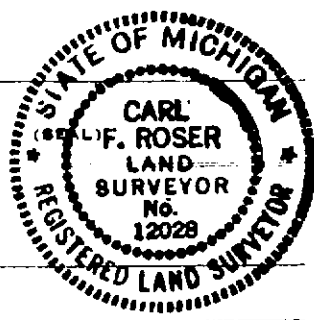

GRAND TRAVERSE COUNTY
GRANT TOWNSHIP

SURVEYOR'S MICHIGAN REGISTRATION NO. _____