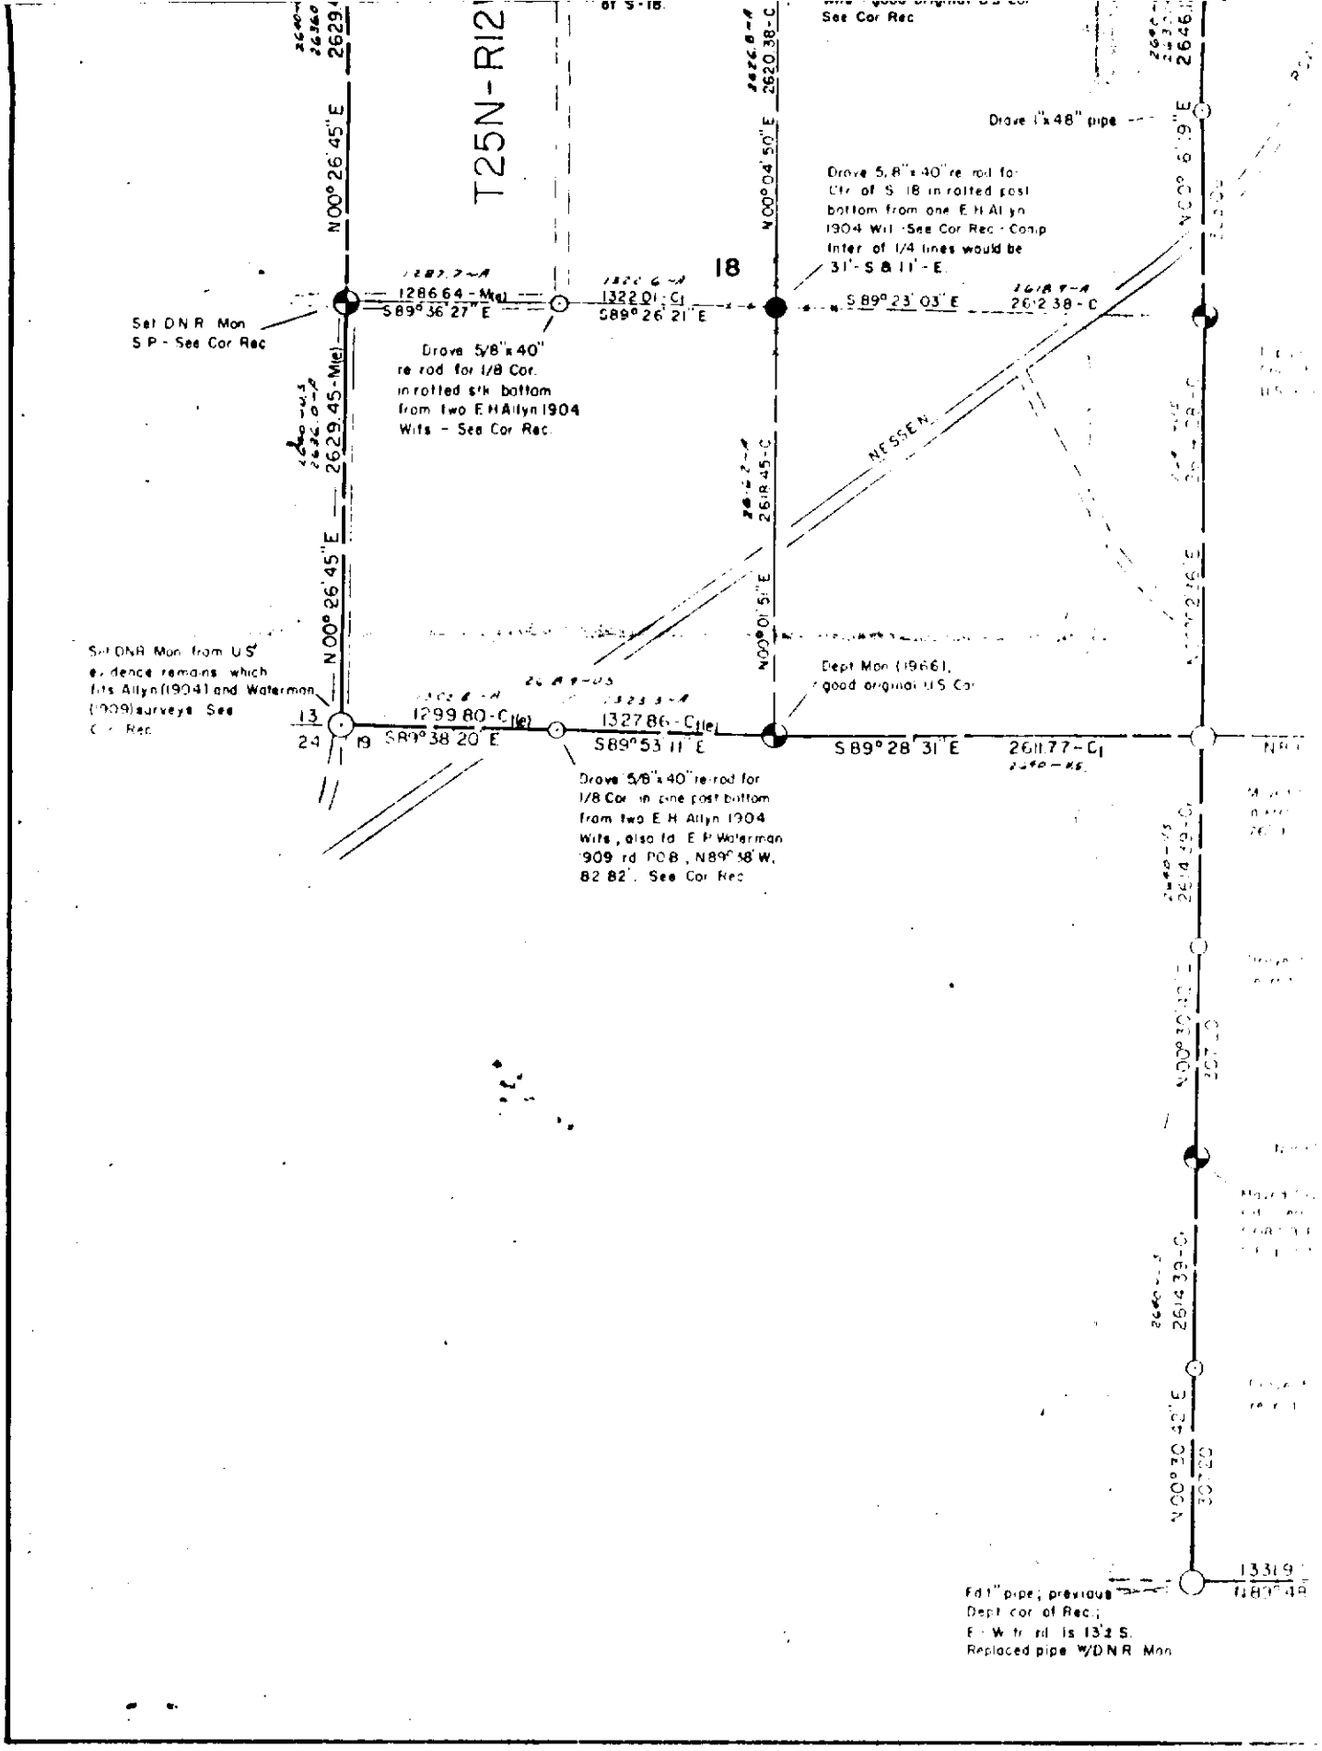
T25N-R12
18
N 00° 26' 45" E
2629.45-Mte
N 00° 04' 50" E
2620.38-C
N 00° 01' 51" E
2618.45-C
N 00° 26' 45" E
See Cor Rec
Drove 1"x48" pipe
Drove 5/8"x40" re rod for Ctr of S 18 in rotted post bottom from one E H Allyn 1904 Wit - See Cor Rec - Comp Inter of 1/4 lines would be 31'-S & 11'-E.
1286.64-Mte
S 89° 36' 27" E
1322.01-C1
S 89° 26' 21" E
S 89° 23' 03" E
2612.38-C
Set D N R Mon S P - See Cor Rec
Drove 5/8"x40" re rod for 1/8 Cor. in rotted stk bottom from two E H Allyn 1904 Wits - See Cor Rec.
NESSEN
Set DNR Mon from U S evidence remains which fits Allyn (1904) and Waterman (1909) surveys See Cor Rec
Dept Mon (1966), good original U S Cor
13
24
19
1299.80-C1(e)
S 89° 38' 20" E
1327.86-C1(e)
S 89° 53' 11" E
S 89° 28' 31" E
2611.77-C1
Drove 5/8"x40" re rod for 1/8 Cor in pine post bottom from two E H Allyn 1904 Wits, also fd E P Waterman 1909 rd POB, N 89° 38' W, 82.82'. See Cor Rec
N 00° 30' 42" E
1331.9'
Fd 1" pipe; previous Dept cor of Rec; E-W tr rd is 13'± S. Replaced pipe w/DNR Mon