

MICHIGAN
DEPARTMENT OF CONSERVATION
FORESTRY DIVISION

LAND CORNER RECORD

T. 26 N.R. 9 W


GRAND TRAVERSE COUNTY

DESCRIPTION OF CORNER M. C. corner common to Sections 6 & 7

CORNER MONUMENT Found Concrete Monument at East Side of Rennie Lake

DATE MONUMENT PLACED AND WITNESSED December 1968

WITNESSES TO CORNER.....

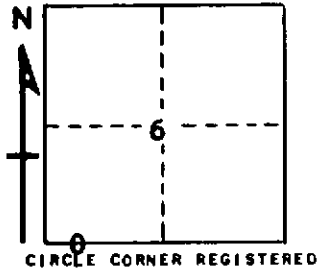

NOT WITNESSED

AND

DESCRIPTION IN DETAIL AS TO HOW CORNER WAS LOCATED AND IDENTIFIED OR RESTORED.

This corner was recovered during retracement survey in this area. The corner is believed to be a result of surveys in the area by Norton & Associates.

SURVEYOR'S SEAL

SIGNED Paul F. Boer DATE 1/19/69
REGISTERED LAND SURVEYOR #12028