

LAND CORNER RECORDATION CERTIFICATE

FILING REQUIREMENT OF ACT 74, MICH. P.A.1970

FOR CORNERS OF--	LOCATED IN--	CORNER CODE NUMBER
1. PUBLIC LAND SURVEY	T. 26 N. W. R. 9 E. W.	K-1, I-3, J-3, K-3
2. PROPERTY CONTROLLING IN SECTION	2, T. 26 N. W. R. 9 E. W.	15
3. MISCELLANEOUS PROPERTY IN SECTION	T. N. S. R. E. W.	
4. LOT NO. _____, RECORDED PLAT _____		
5. PRIVATE CLAIMS _____		

REGISTER OF DEEDS STAMP AND FILING NUMBER

I, Carl F. Roser do hereby certify that under requirements of P.A. 74, Michigan P.A. of 1970, the corner points mentioned in lines 1 and 2 above (identified with circles on index code diagram-over) were, in a field survey on 9-11-73 19___, established, re-established, monumented, re-monumented, recovered or restored as expressed below and in conformance with regulations and rules therefore as required in the current manual of survey instructions of the United States Department of the Interior, Bureau of Land Management or by a decree of a court of law. Furthermore, that the corner points mentioned in lines 3, 4 and 5 above were, in a field survey on _____ 19___, found, recovered, restored, established or re-established as expressed below and in conformance with the rules of the Michigan State Board of Registration for Land Surveyors or, by a Decree of a Court of law:

~~A. Description of original monument and accessories and/or subsequent restoration.~~

B. Cont. Cor. Code #15	C. Cont. Cor. Code #15	B. Cont. I-3	C. Cont. I-3
Estab. Cor. mid-way & on line bet. 1/4 Cor. E & 1/2 Sec. Cor. W.	Set 1" x 20" Pipe (buried 0.3') in N. Wheel Track of E-W fire lane rd.	Previous Dept. Cor. of record. Schaaf Mon. & E. H. Allyn Cor. 1906.	Fd. Schaaf Mon. (buried); Added D.N.R. Mon. 1959 Wit. OK
	7" W. Pine N55°E 53.8'		14" R. Pine N60°W 25.5'
	6" W. Pine S25°E 43.0'		8" Twn. Oak S43°W 40.1'
	Set Ced. Post Due N. 33'		5" R. Pine S16°E 48.5'
	W/loc. Tag		Set Ced. Post N45°W 33'
			W/loc. Tag

B. Description of corner evidence found and/or method applied in restoring or re-establishing corner:

K-3	J-3	K-1
Fd. Schaaf Mon. (1" pipe nipple in conc. block) at intersection of fire lane & rail rd. W&S. Fd. from U.S. B.T. (W.P. stump, N67°W, 13.5'), badly decayed but very visible, & Schaaf pits 33' SW&NE. Schaaf survey Dec. 1933.	Re-established Cor. equidistant & on line between Sec. Cor's to E. & W. Fd. 1" Pipe (New) N73°W 14.8' on b'lage & lath line N. & 1/2 pipe at Approx. 2640' N. Pipes set by local land owner are Approx. Cor's only per Geo-physic's survey.	Fd. shadow of Stk. bottom from original U.S. B.T. (W.P. stub, NW-still standing) and Schaaf Pit NW.

C. Description of monument for corner and accessories established to perpetuate locating the position of the corner:

K-3	J-3	K-1
Set D. Schaaf Mon. (buried 0.5'); Added D.N.R. Mon.	Set D.N.R. Mon. (buried 0.5') in N. Wheel Track of E-W rd.	Set D.N.R. Mon. (buried) by stk. bottom, at approx. inter. of fire lane rds N-S-E-W.
5" Twn. Oak N37°W 40.2'	6" R. Pine S26°E 25.6'	24" W.P. Stub (U.S. 18") N61 1/2°W 107.6'
8" Oak S43°W 63.9'	7" W. Pine S08 1/2°W 35.6'	9" R. Pine N22°W 80.6'
12" Twn. Oak S40°E 20.7'	Set Ced. Post Due S. 33'	8" J. Pine S25°W 61.6'
1/2" 3/4" Pipe-New (drove 2' deep) N84°W 3.2'	W/loc. Tag	Set Ced. Post W/loc. Tag. S45°E 40'
Set Ced. Post S45°W 33'		
W/loc. tag		


SIGNED BY Carl F. Roser DATE 9-15-73

SURVEYOR'S MICHIGAN REGISTRATION NO. 12028

FOR STATE AND UNITED STATES AGENCIES:

SIGNED BY _____ DATE _____
CHIEF OF SURVEY PARTY

APPROVED AND SIGNED BY _____ DATE _____
MICHIGAN REGISTERED LAND SURVEYOR

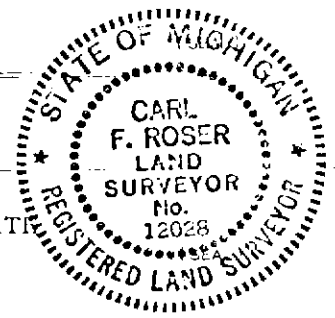

SURVEYOR'S MICHIGAN REGISTRATION NO. _____