

MICHIGAN
DEPARTMENT OF CONSERVATION
FORESTRY DIVISION

LAND CORNER RECORD

T. 26 M.R. 9 W


GRAND TRAVERSE COUNTY

DESCRIPTION OF CORNER Sec. corner common to Sections 4-5-8-9

CORNER MONUMENT Set Brass Cap on 1x12" pipe inside found 1½"x48" pipe in creek.

DATE MONUMENT PLACED AND WITNESSED December 1968

WITNESSES TO CORNER..... 14" Tam. S 88 W 33.3'

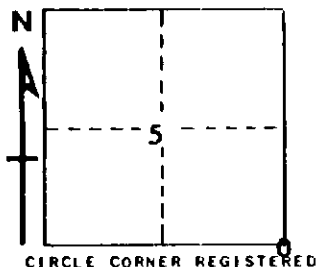

8" Cedar S 40 W 16.0'

9" Tam. S 55 E 49.1'

AND

Cedar Guard Post Due N. 33'

DESCRIPTION IN DETAIL AS TO HOW CORNER WAS LOCATED AND IDENTIFIED OR RESTORED.

This corner was found as a 1½" pipe. Schaff notes show he had an original corner here in 1933.

SURVEYOR'S SEAL

SIGNED

Carl J. Bauer

REGISTERED LAND SURVEYOR

#12028

DATE

1/14/69