

MICHIGAN
DEPARTMENT OF CONSERVATION
FORESTRY DIVISION

LAND CORNER RECORD

T. 26 N.R. 9 W


GRAND TRAVERSE COUNTY

DESCRIPTION OF CORNER 1/4 corner common to Sections 4 - 5

CORNER MONUMENT Set Std. Dept. Mon and Cedar Guard Post

DATE MONUMENT PLACED AND WITNESSED Dec. 1968

WITNESSES TO CORNER.....

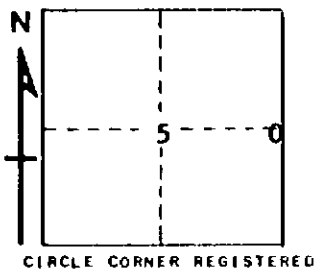

8" R. Pine	N 5 W	61.6'
14" Oak	S 35 W	15.7'
AND		
16" Oak	S 50 E	44.0'
E-W Trail Road	DUE S.	22'

DESCRIPTION IN DETAIL AS TO HOW CORNER WAS LOCATED AND IDENTIFIED OR RESTORED.

This corner was set by single proportion between found section corners to N & S.

SURVEYOR'S SEAL

SIGNED

Carl F. Rover
REGISTERED LAND SURVEYOR

DATE 1/13/69

#12028