

MICHIGAN  
DEPARTMENT OF CONSERVATION  
FORESTRY DIVISION

# LAND CORNER RECORD

T. 26 N.R. 9 W.


Grand Traverse COUNTY

DESCRIPTION OF CORNER 1/4 corner common to Sections 8 - 17

CORNER MONUMENT Left 1 1/4" pipe in place

DATE MONUMENT PLACED AND WITNESSED March 4, 1964

WITNESSES TO CORNER.....

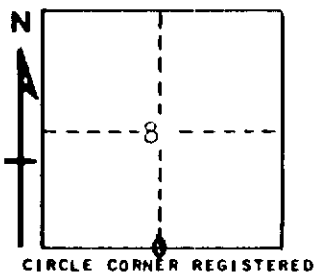

8" Cedar S 53 W 28.9'

9" Cedar S 42 E 43.5'

AND

CIRCLE CORNER REGISTERED

**DESCRIPTION IN DETAIL AS TO HOW CORNER WAS LOCATED AND IDENTIFIED OR RESTORED.**

This corner was found while making a survey in this Township. Found 1 1/4" pipe at corner, as previously restored by Marcus Schaaf, R. L. S., in 1930s. Corner was originally recovered in early 1900s by County Surveyor and rewitnessed. His NBTs still in place. One stump for Govt. B.T. in place NW.

SURVEYOR'S SEAL

SIGNED *Kenneth J. Ostling* DATE June 19, 1964  
REGISTERED LAND SURVEYOR #10068