

MICHIGAN
DEPARTMENT OF CONSERVATION
FORESTRY DIVISION

LAND CORNER RECORD

T. 26 N.R. 9 W

GRAND TRAVERSE COUNTY


DESCRIPTION OF CORNER XXX 1/4 Corner common to Sections 17-18

CORNER MONUMENT Set Std. Dept. Mon (Buried) in approx. ctr. of Old N-S Road Grade.

Note: Road is now a ditch dyke.

DATE MONUMENT PLACED AND WITNESSED 12/4/68

WITNESSES TO CORNER.....

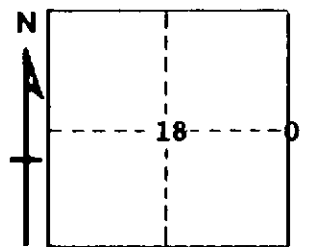

CIRCLE CORNER REGISTERED

	Nail & Tag in W. Side of Power pole	N 03 E	159.5'
	5" Balsam	N 87 W	56.3'
AND	5" B. Cherry	S 40 W	15.9'
	E-W Fence	Due N	1.0'

DESCRIPTION IN DETAIL AS TO HOW CORNER WAS LOCATED AND IDENTIFIED OR RESTORED.

This corner was set for Lat. by "calls" in US notes N. from N. margin of Twenty-two Creek (99') which fits the survey of Sec. 18 by E. H. Allyn in 1906, L. 2, P 234. For Dep. the corner was set in the approximate center of what was once an old N-S Road Grade, which fits a straight line between Sec. corners to N & S.

SURVEYOR'S SEAL

SIGNED

Carl F. Weaver

REGISTERED LAND SURVEYOR #12028

DATE 1/8/69