

MICHIGAN
DEPARTMENT OF CONSERVATION
FORESTRY DIVISION


LAND CORNER RECORD

T. 26 N.R. 9 W

GRAND TRAVERSE COUNTY

DESCRIPTION OF CORNER Sec. corner common to Sections 7-8-17-18
 CORNER MONUMENT Set Std. Dept. Monument (buried) at S edge of E-W dirt road and in line with fenceremains to the N.
 DATE MONUMENT PLACED AND WITNESSED 12-4-68

WITNESSES TO CORNER.....

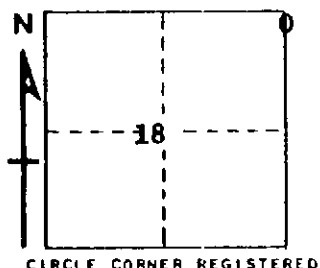

West end of 15" CMP S 70 W 12.7'

East end of 15" CMP S 60 E 9.3'

AND
 Ctr. E-W Gr. Road. Due N. 10'

DESCRIPTION IN DETAIL AS TO HOW CORNER WAS LOCATED AND IDENTIFIED OR RESTORED.

This corner was set very closely by double proportion (5' ±). The actual position was arrived at by: Lat. = twice the distance from E ¼ to S.E. corner of Sec. 18 which fits the "calls" in U.S. Notes N. to Boardman River and S. to Twenty-two Creek, which fits survey data of Sec. 18 by E. H. Allyn in 1906, L.2, P 234.

Dep.: Single proportion (U.S.) between found 1/4 corners to E & W which fits Allyn survey of Sec. 18 and his notes of Survey of Sec. 17, L.2, P 236, which fits the center of old road grade to South.

Allyn notes on Sec. 18 also called for the NE corner to be 24 feet South of a line from the NW corner of Sec. 18 through the N ¼ of Sec. 18 prolonged. Our corner works out to be about 17 feet South of the prolonged line.

SURVEYOR'S SEAL

SIGNED

Carl F. Reer

DATE

1/7/69

REGISTERED LAND SURVEYOR

#12028