

MICHIGAN
DEPARTMENT OF CONSERVATION
FORESTRY DIVISION

LAND CORNER RECORD


T. 26 N.R. 9 W
T 26 N.R. 10 W Grand Traverse COUNTY

DESCRIPTION OF CORNER Section corner common to sections 19 - 30 - 24 - 25

CORNER MONUMENT Left 1 1/4" pipe in place in road intersection

DATE MONUMENT PLACED AND WITNESSED 8-28-63

WITNESSES TO CORNER.....

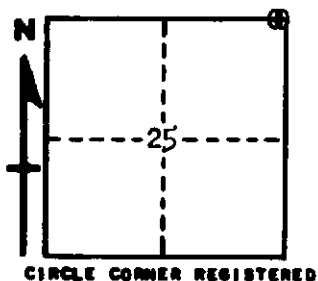

10" W. Oak - S 49 W - 87.5

12" W. Oak - S 47 E - 64.0

AND

DESCRIPTION IN DETAIL AS TO HOW CORNER WAS LOCATED AND IDENTIFIED OR RESTORED.

This corner was found while making a survey of Section 25. Found 1 1/4" pipe in place at road intersection as previously established by unknown Surveyor. Nothing left for USBTS but must be considered properly located.

SURVEYOR'S SEAL

SIGNED *Kenneth Melling* #10068 DATE 9/18/63
REGISTERED LAND SURVEYOR