

MICHIGAN
DEPARTMENT OF CONSERVATION
FORESTRY DIVISION

LAND CORNER RECORD

T. 26 N. R. 9 & 10 W


GRAND TRAVERSE COUNTY

DESCRIPTION OF CORNER Sec. corner common to Sections 7-18-12-13

CORNER MONUMENT Found 1½" pipe. Replaced with Std. Dept. Mon. and Cedar Guard Post

DATE MONUMENT PLACED AND WITNESSED December 1968

WITNESSES TO CORNER.....

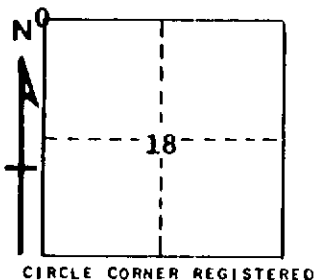

9" Oak S 02 E 12.1'

10" Oak S 85 W 50.4'

AND

12" Oak N 35 E 16.5'

DESCRIPTION IN DETAIL AS TO HOW CORNER WAS LOCATED AND IDENTIFIED OR RESTORED.

This corner was found as a 1½" Pipe. Good USBT stumps still intact. Allyn had this corner in 1906. Schaaf had it in 1933.

SURVEYOR'S SEAL

SIGNED

Carl F. Bauer

DATE

1/13/69

REGISTERED LAND SURVEYOR

#12028