

**SURVEY & REMONUMENTATION**


LIBER 003 PAGE 762

APR 07 1998

**LAND CORNER RECORDATION CERTIFICATE**  
Filing Requirement of Act 74, Mich. P.A. 1970

For corners in SECTION

<u>Grand Traverse</u> (County)	Located in:	Corner Code #
1. Public Land Survey	T <u>26NR 10W</u>	<u>C-4</u>
	T ___ R ___	_____
	T ___ R ___	_____
	T ___ R ___	_____
2. Property Controlling in Section	S ___ T ___ R ___	_____
	S ___ T ___ R ___	_____
3. Miscellaneous Property in Sec.	S ___ T ___ R ___	_____
	S ___ T ___ R ___	_____

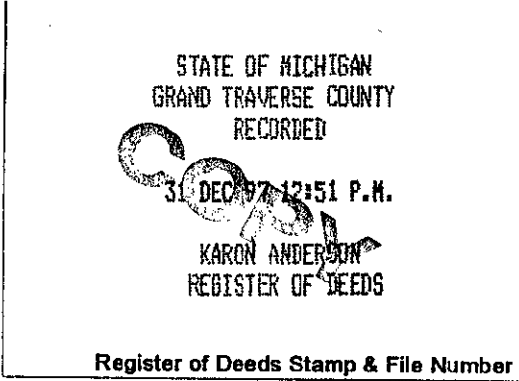

4. Lot No. \_\_\_\_\_, Recorded Plat \_\_\_\_\_  
5. Private Claims \_\_\_\_\_

I, Robert F. Mitchell, in a field survey on Oct., 19 97 do hereby state that under requirements of P.A. 74, Michigan P.A. of 1970, the corner points mentioned in lines 1 and 2 above were in conformance with regulations and rules therefore as required in the current manual of survey instructions of the United States Department of the Interior, Bureau of Land Management or by a decree of a Court of Law and/or that the corner points mentioned in lines 3, 4 and 5 above were in conformance with the rules of the Michigan Board of Land Surveyors or by a Decree of a Court of Law; established, re-established, monumented, recovered, found as expressed below:

NOTE: Not more than 2 corners, all in the same town and range, may be recorded on this certificate.

	A	B	C	D	E	F	G	H	I	J	K	L	M
1													
2	6		5		4		3		2		1		
3													
4	7		●	8		9		10		11		12	
5													
6	18		17		16		15		14		13		
7													
8	19		20		21		22		23		24		
9													
10	30		29		28		27		26		25		
11													
12	31		32		33		34		35		36		
13													

A. Description of original monument and accessories and/or subsequent restoration:

C-4; West 1/4 Cor Sec. 8, T26N, R10W; "Wood post witnessed by Sugar 8" N08°W 4 lks & Hemlock 14" S28°E 11 lks", U.S. Survey by L.S. Scranton dated July 1852. "Stake in place, correct by both wits standing", survey by Co. Surveyor Samuel Hodgeman dated July 5, 1882 & on file in the Co. Surveyors records of Grand Traverse Co. "Cor 38 is a stake & iron, no witness", a petition survey by E.P. Waterman Co. Surveyor dated April 7th-10th, 1914 & recorded in Ek.2, Pg.456 of the Co. Surveyors records of Grand Traverse Co. "Iron found", the unrecorded survey by Gourdie Fraser & Assoc. dated May 31, 1984 and on file at their office at 124 W. State St., Traverse City. "Iron found", an unrecorded survey by Gosling-Czubak & Assoc. dated Oct. 22, 1992 and on file at their office. "Found railroad rail on end with "X"", an unrecorded Certified Survey by Phillip D. Case on file with Mitchell & Assoc. in Kingsley.


B. Description of corner evidence found and/or method applied in restoring or reestablishing corner:

C-4; West 1/4 Cor Sec 8, T26N, R10W; Found railroad rail on end as called for in the Mitchell & Assoc. survey referenced in Sec. "A" above and is accepted as a careful & faithful perpetuation of the position of the original cor. Remonumented this position with a 2 1/2" by 30" flanged bottom galvanized iron pipe w/3/4" brass Cap stamped GRAND TRAVERSE CO. REMONUMENTATION.

C. Description of monument for corner and accessories established to perpetuate locating the position of the corner:

UNANIMOUSLY ACCEPTED BY THE GRAND TRAVERSE COUNTY PEER REVIEW GROUP AS THE OFFICIAL CORNER UNDER MICHIGAN PUBLIC ACT 345 OF 1990 AT A MEETING HELD ON 11-5-97  
Robert F. Mitchell  
ROBERT F. MITCHELL, P.S., CI (Aln)MAN

C-4  
West 1/4 Cor Sec. 8, T26N, R10W  
2 1/2" by 30" flanged bottom galvanized iron pipe w/3/4" brass Cap stamped GRAND TRAVERSE CO. REMONUMENTATION  
S21°E - 5" Red Pine - 4.75'  
S72°E - 5" Red Pine - 26.70'  
S85°E - 5" Red Pine - 28.82'  
East - 1/2" rerod - 20.14'  
N11°E - 8" Beech - 144.22'

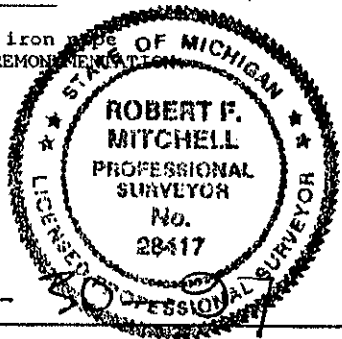

Signed by Robert F. Mitchell  
Surveyor's Michigan License No. 28417

Date 12-30-97