

MICHIGAN  
DEPARTMENT OF CONSERVATION  
FORESTRY DIVISION

# LAND CORNER RECORD

T. 26 N. R. 10 W.


Grand Traverse COUNTY

DESCRIPTION OF CORNER 1/4 corner common to Sections 25 - 36

CORNER MONUMENT Set 1" pipe with 4" brass cap

DATE MONUMENT PLACED AND WITNESSED October 17, 1963

WITNESSES TO CORNER.....

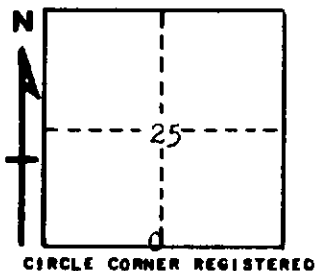

10" W. Oak N 30 W 53.8'

12" W. Oak N 40 E 51.4'

AND

**DESCRIPTION IN DETAIL AS TO HOW CORNER WAS LOCATED AND IDENTIFIED OR RESTORED.**

This corner was restored while making a survey of Section 25. Found a large stone (8" x 8" x 18") set at fence corner probably established in previous survey. Conforms acceptably with surrounding occupation and fits pattern of survey for this section. Considered best available evidence.

SURVEYOR'S SEAL

SIGNED *Kenneth J. Ostling* DATE December 16, 1963  
REGISTERED LAND SURVEYOR