

MAR 16 1994

LAND CORNER RECORDATION CERTIFICATE
Filing Requirement of Act 74, Mich. P.A. 1970

For corners in **COMMISSION**
GRAND TRAVERSE
(County)

	Located In:		Corner Code #
1. Public Land Survey	T <u>26N</u>	R <u>11W</u>	<u>C-9</u>
	T _____	R _____	_____
	T _____	R _____	_____
	T _____	R _____	_____
2. Property Controlling in Section	S _____	T _____	R _____
	S _____	T _____	R _____
3. Miscellaneous Property in Sec.	S _____	T _____	R _____
	S _____	T _____	R _____

STATE OF MICHIGAN
GRAND TRAVERSE COUNTY
RECORDED
30 DEC 93 10:15 A.M.
KARON ANDERSON
REGISTER OF DEEDS
Register of Deeds Stamp & File Number

4. Lot No. _____, Recorded Plat _____
5. Private Claims _____

I, Gary G. Wilson, in a field survey on December 17, 19 93, do hereby certify that under requirements of P.A. 74, Michigan P.A. of 1970, the corner points mentioned in lines 1 and 2 above were in conformance with regulations and rules therefore as required in the current manual of survey instructions of the United States Department of the Interior, Bureau of Land Management or by a decree of a Court of Law and/or that the corner points mentioned in lines 3, 4 and 5 above were in conformance with the rules of the Michigan Board of Land Surveyors or by a Decree of a Court of Law; established, re-established, monumented, re-monumented, recovered, found as expressed below:

NOTE: Not more than 4 corners, all in the same town and range, may be recorded on this certificate.

A. Description of original monument and accessories and/or subsequent restoration:

C-9: Original Gov't witnesses: 14" Sugar, S40°E, 66.6'
10" Sugar, N56°E, 70.0'
E.H. Allyn found old corner from stump of old witness and set galvanized Act 74 filed by Larry Gerschbacher in July, 1974 (per Liber 2, Pg. 60).

iron pipe 36" x 1", with stones.

	A	B	C	D	E	F	G	H	I	J	K	L	M
2	6		5		4		3		2		1		
3													
4	7		8		9		10		11		12		
5													
6	18		17		16		15		14		13		
7													
8	19		20		21		22		23		24		
9													
10	30		29		28		27		26		25		
11													
12	31		32		33		34		35		36		
13													


B. Description of corner evidence found and/or method applied in restoring or reestablishing corner:

C-9: No physical evidence of the original GLO witnesses were found.
Found 1" iron bar in monument box at centerline of Norton and Lemcool Roads.

C. Description of monument for corner and accessories established to perpetuate locating the position of the corner:

C-9: 1/4 corner common to Sections 19, 20, 29 & 30
Perpetuated with 2-1/2" X 30" flanged bottom galvanized iron pipe with 3-1/2" brass cap
TRAVERSE COUNTY REMONUMENTATION.
S40°E 66.90' 48" Maple
S52°W 67.40' 12" Red Pine
N36°w 54.96' Power Pole

stamped GRAND

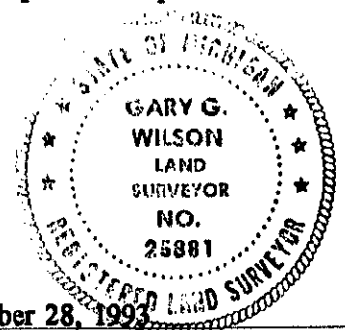

Corner approved by the Grand Traverse County Peer Review Group on ~~11-03-93~~ ^{12-15-93 GW}

Signed by Gary G. Wilson
Gary G. Wilson, PS
Surveyor's Michigan License No. 25881

Date December 28, 1993