

LAND CORNER RECORDATION CERTIFICATE

FILING REQUIREMENT OF ACT 74, MICH. P.A.1970

FOR CORNERS OF--	LOCATED IN--	CORNER CODE NUMBER
1. PUBLIC LAND SURVEY	T. 26 N. R. 11 W.	L-5; L-6
2. PROPERTY CONTROLLING IN SECTION	T. N. S. R. E. W.	
3. MISCELLANEOUS PROPERTY IN SECTION	T. N. S. R. E. W.	
4. LOT NO. _____, RECORDED PLAT _____		
5. PRIVATE CLAIMS _____		

REGISTER OF DEEDS STAMP AND FILING NUMBER _____

I, CARL F. ROSER, do hereby certify that under requirements of P.A. 74, Michigan P.A. of 1970, the corner points mentioned in lines 1 and 2 above were, in a field survey on FEBRUARY 3, 1983, established, re-established, monumented, re-monumented, recovered or restored as expressed below and in conformance with regulations and rules therefore as required in the current manual of survey instructions of the United States Department of the Interior, Bureau of Land Management or by a decree of a court of law. Furthermore, that the corner points mentioned in lines 3, 4 and 5 above were, in a field survey on _____, 19____, found, recovered, restored, established or re-established as expressed below and in conformance with the rules of the Michigan State Board of Registration for Land Surveyors or, by a Decree of a Court of law:

A. Description of original monument and accessories and/or subsequent restoration:

B. Description of corner evidence found and/or method applied in restoring or re-establishing corner:

- L-5 FD PIPE AS RECOVERD BY RLS, WM. BATZER IN 1981. SEE CERTIFICATE OF SURVEY'S, LIBER 3, PAGE 958, LIBER 2, PG 764 & LIBER 2, PG 420 & 601.
- L-6 FD 1 1/4" PIPE THAT FITS RECORDED PLAT OF "BOARDMAN ACRES", DATED OCT 1948; ACCEPTED FOR CTR OF SEC 13. THIS PIPE ALSO WAS ACCEPTED AS CTR OF SEC 13 BT RLS, MATT KOIVISTO, IN 1977. A CALC POSITION FOR CTR OF SEC 13 AT INERSECTION OF 1/4 LINES WOULD BE 6'± SOUTH. SINCE THE W 1/4 COR OF SEC 13 COULD BE CONSIDERED SOME-WHAT QUESTIONABLE; THERE IS LITTLE POINT IN NOT ACCPETING 1 1/4" PIPE FOR CTR OF SEC 13.

C. Description of monument for corner and accessories established to perpetuate locating the position of the corner:

<u>L-5</u>	<u>L-6</u>
FD 1 1/4" X 30" PIPE, REPLACED W/1" X 72" PIPE W/RLS CAP & CEDAR POST W/LOC TAG	FD 1 1/4" PIPE & SET CEDAR POST W/LOC TAG
*10" ASH S50°W 4.85	6" ASPEN S56°E 8.98
* 5" CEDAR EAST 11.32	6" ASPEN N50°W 9.12
* 3" CEDAR N05°W 7.48	4" ASPEN S20°E 27.42
	CTR OF PVT DR (IN CURVE) S70°W 69'±

* = BATZER WITS.

SIGNED BY Carl F. Roser 06/02/83 DATE _____

SURVEYOR'S MICHIGAN REGISTRATION NO. 12028


FOR STATE AND UNITED STATES AGENCIES:

SIGNED BY _____ DATE _____

CHIEF OF SURVEY PARTY

APPROVED AND SIGNED BY _____ DATE _____

MICHIGAN REGISTERED LAND SURVEYOR

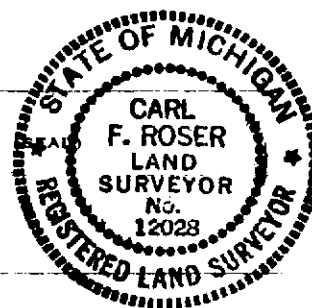

(SEAL)

SURVEYOR'S MICHIGAN REGISTRATION NO. _____ BLAIR TWP.
GRAND TRAVERSE COUNTY