LAND CORNER RECORDATION CERTIFICATE

Filing Requirement of Act 74, Mich. P.A. 1970

Filed 7-24-89 gw

For corners in GRAND TRAVERSE (County)

	Located In:	Corner Code 11
1. Public Land Survey	T 26N R 11W	J-9
	T ___ R ___	J-11
	T ___ R ___	
	T ___ R ___	
2. Property Controlling	S 26 T ___ R ___	12
in Section	S 26 T ___ R ___	14
3. Miscellaneous	S ___ T ___ R ___	
Property in Sec.	S ___ T ___ R ___	

Register of Deeds Stamp & File Number

4. Lot No. _____ , Recorded Plat _____
5. Private Claims _____

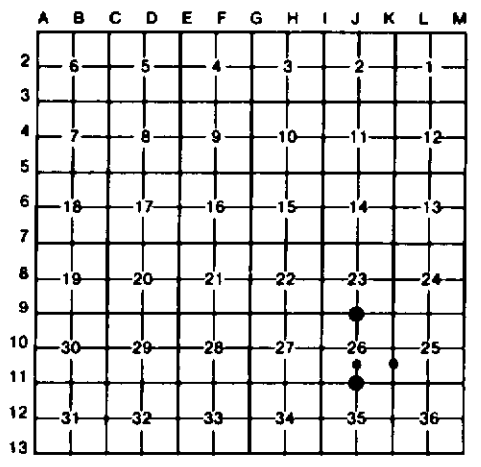

I, CARL F. ROSER, in a field survey on OCTOBER 19, 19 84, do hereby certify that under requirements of P.A. 74, Michigan P.A. of 1970, the corner points mentioned in lines 1 and 2 above were in conformance with regulations and rules therefore as required in the current manual of survey instructions of the United States Department of the Interior, Bureau of Land Management or by a decree of a Court of Law and/or that the corner points mentioned in lines 3, 4 and 5 above were in conformance with the rules of the Michigan Board of Land Surveyors or by a Decree of a Court of Law; established, re-established, monumented, re-monumented, recovered, found as expressed below:

NOTE: Not more than 4 corners, all in the same town and range, may be recorded on this certificate.

A. Description of original monument and accessories and/or subsequent restoration:

J-9	J-11	12	14
RE-ESTAB N1/4 COR S-26 NOWAY & ON LINE BETWEEN FD CORS @ NW & NE COR S-26. CTR E-W SAND TR IS 16'± N. CTR SAND TR N IS 45'± E.	S 1/4 COR S-26;FD 1 1/4"PIPE THAT FITS ONE E.P.WATERMAN WIT OF 1912-13 SURV OF S-35 T26N-R11W (E.P.N.CALLED FOR 1 1/2" PIPE & BUG 10 S19°E 33' & BUG S N81°E 23';FD SUG SE OK, SUG NE GONE).	ESTAB SW COR OF N 1/2 OF SE1/4 OF S-26 PER STD BLM INSTRS.	ESTAB SE COR OF N1/2 OF SE 1/4 OF S-26 PER STD BLM INSTRS. S EDGE OF CR IS 70± N. FD.OLD SQ CEDAR POST N 06°E 14 1/2' (BELIEVED TO BE SET BY DNR FORESTER IN EARLY 1950'S).

B. Description of corner evidence found and/or method applied in restoring or reestablishing corner:

J-9	J-11	12	14

C. Description of monument for corner and accessories established to perpetuate locating the position of the corner:

J-9			J-11			12			14		
SET DNR MON & CEDAR POST			FD 1 1/4" X 3 1/2" PIPE;ADDED DNR MON & CEDAR POST			DROVE 5/8"X34" REBD W/RLS CAP & SET CEDAR POST W/LDC TAG.			DROVE 3/8" X 48" PIPE W/RLS CAP & SET CEDAR POST W/LDC TAG		
4" TAMARACK	S26°W	64.8'	#16" MAPLE	N85°W	16.00'	3" MAPLE	N 30°E	24.4'			
5" TAMARACK	S70°W	46.4'	15" B.WOOD	S40°E	14.75'	11" MAPLE	S 56°E	42.5'	5 " CEDAR	S 30°W	6.4'
7" CEDAR	N68°W	99.9'	#22" MAPLE	S15°E	33.18'	8" CEDAR	N 44°W	14.6'	16" MAPLE	N 50°W	25.2'
8" CEDAR	N45°E	88.5'	7" MAPLE	S45°W	13.3'				7" CEDAR	N 60°E	14.0'
			CTR E-W SAG LN OPENING	N	85'±						

#J.NELSON,L.S.#21273 WIT.TAG.

Signed by Carl F. Roser 10-25-88 Date _____

Surveyor's Michigan License No. 12028

STATE OF MICHIGAN CARL F. ROSER LAND SURVEYOR No. 12028 REGISTERED LAND SURVEYOR

FORM APPROVED BY MICHIGAN STATE BOARD OF LAND SURVEYORS