LAND CORNER RECORDATION CERTIFICATE

Filing Requirement of Act 74, Mich. P.A. 1970

filed 7-24-89 ~~

For corners in GRAND TRAVERSE (County)

	Located In:	Corner Code ##
1. Public Land Survey	T 26N R 11W	K-10
	T ___ R ___	K-11
	T ___ R ___	L-11
	T ___ R ___	
2. Property Controlling	S ___ T ___ R ___	
in Section	S ___ T ___ R ___	
3. Miscellaneous	S ___ T ___ R ___	
Property in Sec.	S ___ T ___ R ___	

Register of Deeds Stamp & File Number

4. Lot No. _____ , Recorded Plat _____
5. Private Claims _____

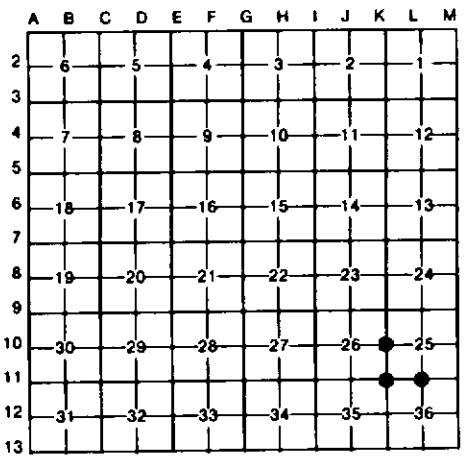

I, CARL F. ROSER, in a field survey on NOVEMBER 13, 19 84, do hereby certify that under requirements of P.A. 74, Michigan P.A. of 1970, the corner points mentioned in lines 1 and 2 above were in conformance with regulations and rules therefore as required in the current manual of survey instructions of the United States Department of the Interior, Bureau of Land Management or by a decree of a Court of Law and/or that the corner points mentioned in lines 3, 4 and 5 above were in conformance with the rules of the Michigan Board of Land Surveyors or by a Decree of a Court of Law; established, re-established, monumented, re-monumented, recovered, found as expressed below:

NOTE: Not more than 4 corners, all in the same town and range, may be recorded on this certificate.

A. Description of original monument and accessories and/or subsequent restoration:

K-10

K-11

L-11

B. Description of corner evidence found and/or method applied in restoring or reestablishing corner:

K-10

ESTAB'D E 1/4 COR S-26 MIDWAY & ON LINE BETW FD SEC COR'S 1/2 MILE TO N & S. FD OLD SQ CED POST N21°E 10.7' (BELIEVED TO BE SET BY DNR FORESTER, FRED HASKINS IN EARLY 1950'S). COR IS AT S END OF OLD TOTE ROAD (OVERGROWN).

K-11

SE COR S-26; FD 1" PIPE THAT FITS ONE E.P.WATERMAN WIT FROM 1913 SUR OF S-35, T26N, R11W (E.P.W. CALLED FOR IR PIPE) ELM 4 S38 1/2°W 7', W.CHERRY 8 S82°E 1'; FD DEAD ELM STP SW OK, CHERRY SE GONE)

L-11

S 1/4 S-25; FD DNR MON AS SET IN 1969 DEPT SUR AT FD POSITION OF SHADOW OF DARK SOIL CIRCLE WHERE PIPE HAD BEEN SET AND FROM HEMLOCK WIT, NORTH, BY E.P.WATERMAN IN 1907, LIBER 2, PG 278-279 S-36.

C. Description of monument for corner and accessories established to perpetuate locating the position of the corner:

K-10

DROVE 1" X 48" PIPE W/ALUM DNR CAP & SET CED POST.

15" W PINE	S86°E	10.6'
8" CED	S42°W	11.0'
8" CED	N64°W	6.9'
10" CED	N48°E	4.2'

K-11

FD 1" PIPE; ADDED DNR MON & CED POST.

8" MAPLE	S85°W	5.75'
11" MAPLE	N55°E	1.83'
*16" ASH	S60°E	34.08'
* 8" MAPLE	S25°W	24.45'
CTR E-W GAS LINE	OPENING N	90'±

---*OLD WITS---

L-11

FD DNR MON (BURIED 0.5')

* 7" R PINE	S50°E	58.27'
*12" TW ELM STP	S40°E	40.0'
7" R PINE	S20°E	31.5'
FD CED POST W/ NAIL & LOG TAG.	SOUTH	33.23'
CTR OF E-W WINDING SAND ROAD	SOUTH	3'+

---*PREVIOUS DNR WIT ---

Signed by Carl F. Roser 10-25-88 Date _____

Surveyor's Michigan License No. 12028

STATE OF MICHIGAN CARL F. ROSER LAND SURVEYOR No. 12028 REGISTERED LAND SURVEYOR

FORM APPROVED BY MICHIGAN STATE BOARD OF LAND SURVEYORS JAN. 28, 1971
REVISED MAY 14, 1975
REVISED JAN., 1983