LAND CORNER RECORDATION CERTIFICATE

Filing Requirement of Act 74, Mich. P.A. 1970

filed 7-24-89 MW

For corners in
GRAND TRAVERSE
(County)

	Located In:	Corner Code ##
1. Public Land Survey	T 26N R 11W	H-7
	T ___ R ___	H-8
	T ___ R ___	
	T ___ R ___	
2. Property Controlling	S 22 T ___ R ___	1
in Section	S 22 T ___ R ___	2
3. Miscellaneous	S ___ T ___ R ___	
Property in Sec.	S ___ T ___ R ___	

Register of Deeds Stamp & File Number

4. Lot No. _____ , Recorded Plat _____
5. Private Claims _____

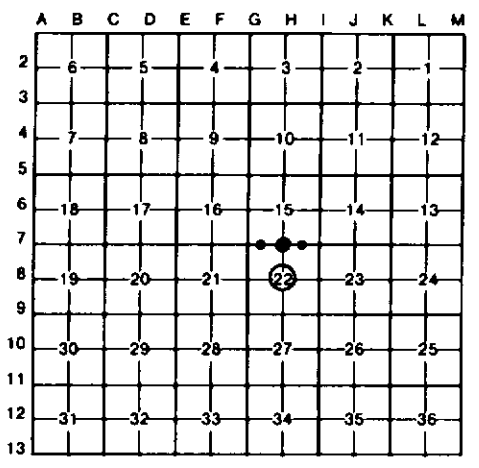

I, CARL F. ROSER, in a field survey on OCTOBER 24, 19 84, do hereby certify that under requirements of P.A. 74, Michigan P.A. of 1970, the corner points mentioned in lines 1 and 2 above were in conformance with regulations and rules therefore as required in the current manual of survey instructions of the United States Department of the Interior, Bureau of Land Management or by a decree of a Court of Law and/or that the corner points mentioned in lines 3, 4 and 5 above were in conformance with the rules of the Michigan Board of Land Surveyors or by a Decree of a Court of Law; established, re-established, monumented, re-monumented, recovered, found as expressed below:

NOTE: Not more than 4 corners, all in the same town and range, may be recorded on this certificate.

A. Description of original monument and accessories and/or subsequent restoration:

H-7
FD 1 1/2" SOLID IRON FOR N 1/4 COR S-22. FD REMAINS OF POSS. E.P.WATERMAN PINE STP WIT, N21°E,75' (EPW = PINE STUB 30 N21°E,74') COR IS IN APPROX CTR OF E-W GRAV RD (±2') AND IN LINE W/CTR OF TRAIL RD TO N.

H-8
ESTAB'D CTR OF S-22 AT INTERSEC OF 1/4 LINES. WE FD 3/8" ROD, AS SET IN ERROR, S89° 32'31"E, 20.02'. CTR E-W SAND TRAIL IS S 42'±.

1
FD 1" PIPE FOR NW COR OF NE 1/4-NW 1/4 OF S-22 IN APPROX CTR E-W GRAVEL RD.

2
ESTAB'D NE COR OF NW 1/4 OF NE 1/4 OF S-22 PER STANDARD BLM INSTRUCTIONS. COR FALLS IN CTR E-W SAND-GRAVEL ROAD.

B. Description of corner evidence found and/or method applied in restoring or reestablishing corner:

H-7
FD 1 1/2" SOLID IRON & RAISED IT WITH 5/8"X 12" REROD W/RLS CAP

13" MAPLE	N36°W	89.2'
20" CHERRY	N42°E	74.3'
5" MAPLE	S54°E	81.9'
2" MAPLE	S35°W	50.2'
SET CED POST/W LOC TAG	NORTH	33'

H-8
DROVE 5/8" X 34" REROD W/RLS CAP & SET CED POST W/LOC TAG.

6" MAPLE	S88°E	31.2'
15" MAPLE	N30°E	33.1'
6" W PINE	N10°W	52.5'
5" MAPLE	N74°W	33.0'

1
FD 1" PIPE IN GRAVEL ROAD.

10" W PINE	N35°E	103.7'
14" W PINE	S46°E	128.3'
8" W PINE	S50°W	86.8'
SET CED POST W/ LOC TAG	NORTH	33'

2
DROVE 5/8" X 34" REROD W/RLS CAP.

13" MAPLE	N28°E	24.0'
8" MAPLE	S36°E	36.8'
11" TW MAPLE	S26°W	23.4'
SET CED POST W/ LOC TAG.	SOUTH	33'

C. Description of monument for corner and accessories established to perpetuate locating the position of the corner:

Signed by Carl F. Roser 10-25-88 Date _____

Surveyor's Michigan License No. 12028

STATE OF MICHIGAN
CARL F. ROSER
LAND SURVEYOR
No. 12028
REGISTERED LAND SURVEYOR

FORM APPROVED BY MICHIGAN STATE BOARD OF LAND SURVEYORS, JAN. 28, 1971
REVISED MAY 14, 1975
REVISED JAN., 1983