

JUN 01 1998

LAND CORNER RECORDATION CERTIFICATE
Filing Requirement of Act 74, Mich. P.A. 1970

SECTION

For corners in

GRAND TRAVERSE

(County)

Located In:

Corner Code #/

1. Public Land Survey

T ²⁶26N R ¹²11W A-8 M-08

2. Property Controlling in Section

S T R

3. Miscellaneous Property in Sec.

S T R

STATE OF MICHIGAN
GRAND TRAVERSE COUNTY
RECORDED

30 DEC 93 10:18 A.M.

KAREN ANDERSON
REGISTER OF DEEDS

Register of Deeds Stamp & File Number

4. Lot No. _____, Recorded Plat _____
5. Private Claims _____

I, Gary G. Wilson, in a field survey on December 17, 19 93, do hereby certify that under requirements of P.A. 74, Michigan P.A. of 1970, the corner points mentioned in lines 1 and 2 above were in conformance with regulations and rules therefore as required in the current manual of survey instructions of the United States Department of the Interior, Bureau of Land Management or by a decree of a Court of Law and/or that the corner points mentioned in lines 3, 4 and 5 above were in conformance with the rules of the Michigan Board of Land Surveyors or by a Decree of a Court of Law; established, re-established, monumented, re-monumented, recovered, found as expressed below:

NOTE: Not more than 4 corners, all in the same town and range, may be recorded on this certificate.

A. Description of original monument and accessories and/or subsequent restoration:

A-8: Original GLO notes and witnesses

B. Description of corner evidence found and/or method applied in restoring or reestablishing corner:

A-8: No physical evidence of the original GLO witnesses were found.
Found 3/4" iron pipe in monument box 1 ft. West of the centerline of old down fence to the West.

County Road 633 on line with very

	A	B	C	D	E	F	G	H	I	J	K	L
2	6	5	4	3	2	1						
3												
4	7	8	9	10	11	12						
5												
6	18	17	16	15	14	13						
7												
8	19	20	21	22	23	24						
9												
10	30	29	28	27	26	25						
11												
12	31	32	33	34	35	36						
13												

SURVEY & REMONUMENTATION

JUN 01 1998

SECTION


C. Description of monument for corner and accessories established to perpetuate locating the position of the corner:

A-8: West 1/4 corner of Section 19
Perpetuated with 2-1/2" X 30" flanged bottom galvanized iron pipe with 3-1/2" brass cap stamped GRAND TRAVERSE COUNTY REMONUMENTATION.

- S39°W 59.5' Stump
- N22°E 98.69' Power Pole
- N53°E 107.83' N.W. Cor. of House
- S36°W 146.97' 10" Maple
- S58°E 60.80' 42" White Pine

Corner approved by the Grand Traverse County Peer Review Group on 11-03-93.

Signed by Gary G. Wilson Date December 28, 1993
Surveyor's Michigan License No. 25881

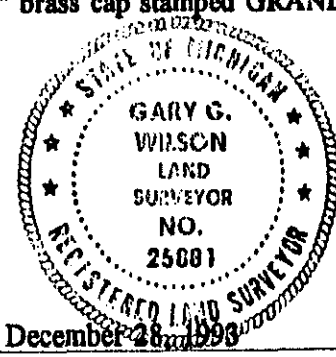

3-496