

MICHIGAN
DEPARTMENT OF CONSERVATION
FORESTRY DIVISION

LAND CORNER RECORD

T. 26 N.R. 12 W


GRAND TRAVERSE COUNTY

DESCRIPTION OF CORNER SEC. CORNER COMMON TO SECTIONS 34 & 35

CORNER MONUMENT SET STD DEPT. MON.

DATE MONUMENT PLACED AND WITNESSED Aug. 1968

WITNESSES TO CORNER..... (Sec. cor. common to Sec. 2 & 3 T25N, R12W)
(N 89 45'E, 88.44')

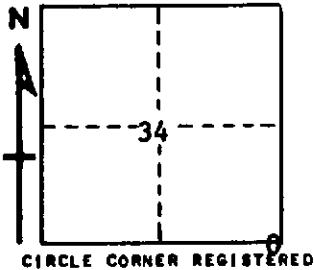

<u>6" Cedar</u>	<u>N 35 W</u>	<u>174.2'</u>
<u>12" Hemlock</u>	<u>N 2 E</u>	<u>132.2'</u>
<u>6" Cedar</u>	<u>N 40 E</u>	<u>145.9'</u>

AND

DESCRIPTION IN DETAIL AS TO HOW CORNER WAS LOCATED AND IDENTIFIED OR RESTORED.

This corner was restored from Grand Traverse County Road Commission witness. They had witnessed existing corners prior to reconstruction of Youker Road, as the construction would obliterate the corners.

SURVEYOR'S SEAL

SIGNED Carl F. Roer DATE 9/16/68
REGISTERED LAND SURVEYOR #12028