

LAND CORNER RECORDATION CERTIFICATE

FILING REQUIREMENT OF ACT 74, MICH. P.A.1970

FOR CORNERS OF—	LOCATED IN—			CORNER CODE NUMBER	
	T.	N. S.	R.	L. W.	
1. PUBLIC LAND SURVEY					
2. PROPERTY CONTROLLING IN SECTION	1	T.	26	N. R. 12	8
3. MISCELLANEOUS PROPERTY IN SECTION	1	T.	26	N. R. 12	* 486.0'-N OF K-2
4. LOT NO. _____, RECORDED PLAT _____					
5. PRIVATE CLAIMS _____					

REGISTER OF DEEDS STAMP AND
FILING NUMBER _____

I, CARL F. ROSER do hereby certify that under requirements of P.A. 74, Michigan P.A. of 1970, the corner points mentioned in lines 1 and 2 above were, in a field survey on APRIL 14, 1982, established, re-established, monumented, re-monumented, recovered or restored as expressed below and in conformance with regulations and rules therefore as required in the current manual of survey instructions of the United States Department of the Interior, Bureau of Land Management or by a decree of a court of law. Furthermore, that the corner points mentioned in lines 3, 4 and 5 above were, in a field survey on 4-14, 1982, found, recovered, restored, established or re-established as expressed below and in conformance with the rules of the Michigan State Board of Registration for Land Surveyors or, by a Decree of a Court of law:

A. Description of original monument and accessories and/or subsequent restoration:

B. Description of corner evidence found and/or method applied in restoring or re-establishing corner.

- 8 - ESTABLISHED THE NE CORNER OF GOVT. LOT 4 MID-WAY AND ON LINE BETWEEN THE W 1/4 CORNER OF SECTION 1 (CALC. POSITION IN BASS LAKE) AND THE CENTER OF SECTION (CALC. POSITION AT INTERSECTION OF ONE-QUARTER LINES). SET 3/4" X 60" PIPE WITH R.L.S. CAP AND CEDAR POST, N56°00'W, 33.85' FROM THE NE CORNER OF GOVT. LOT 4 TO MONUMENT THE DIVISION OF SHORE LINE BETWEEN GOVT. LOT 3 AND GOVT. LOT 4.
- * K-2 RE-ESTABLISH U.S. MEANDER CORNER ON N SIDE OF BASS LAKE ON LINE ACROSS THE NW & SW CORNERS OF SECTION 1 AND AT PRO-RATED DISTANCE TO U.S. (G.L.O. SURVEY). THE W 1/4 CORNER OF SECTION 1 (CALC. POSITION IN LAKE) IS S00°05'E, 485.98'.

C. Description of monument for corner and accessories established to perpetuate locating the position of the corner.

8			* K-2		
SET 5/8" X 36" REROD W/R.L.S. CAP AND CEDAR POST W/LOC. TAG			SET DNR MONUMENT AND CEDAR POST		
15" MAPLE	S05°E	52.2'	15" RED PINE	N70°W	11.80'
5" CEDAR	S70°W	5.8'	10" MAPLE	N15°W	26.16'
4" CEDAR	S60°E	8.1'	4" CEDAR	S50°W	11.93'
WATER'S EDGE	N56°W	50' ±	FD. 1 1/4" PIPE (FLUSH)	S25°54'W	8.90'
WATER'S EDGE	NORTH	55' ±			
SET 3/4" X 60" PIPE W/R.L.S. CAP & CED. POST	N56°00'W	33.85'			


SIGNED BY Carl F. Roser 6-10-82 DATE

SURVEYOR'S MICHIGAN REGISTRATION NO. #12028

FOR STATE AND UNITED STATES AGENCIES:

SIGNED BY _____ DATE _____

APPROVED AND SIGNED BY _____ DATE _____

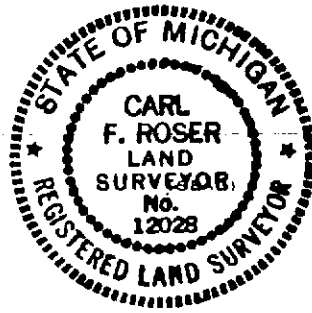

Green Lake Twp
GRAND TRAVERSE COUNTY

SURVEYOR'S MICHIGAN REGISTRATION NO. _____