

LAND CORNER RECORDATION CERTIFICATE

FILING REQUIREMENT OF ACT 74, MICH. P.A.1970

FOR CORNERS OF--:	LOCATED IN--:	CORNER CODE NUMBER
1. PUBLIC LAND SURVEY _____	T. <u>26</u> N. <u>12</u> W. <u>12</u>	M-2
2. PROPERTY CONTROLLING IN SECTION <u>1</u>	T. <u>26</u> N. <u>12</u> W. <u>12</u>	10
3. MISCELLANEOUS PROPERTY IN SECTION <u>1</u>	T. <u>26</u> N. <u>12</u> W. <u>12</u>	2417.93 N. OF K-3
4. LOT NO. _____, RECORDED PLAT _____		
5. PRIVATE CLAIMS _____		

REGISTER OF DEEDS STAMP AND FILING NUMBER

I, CARL F. ROSER, do hereby certify that under requirements of P.A. 74, Michigan P.A. of 1970, the corner points mentioned in lines 1 and 2 above were, in a field survey on 2/1, 1982, established, re-established, monumented, re-monumented, recovered or restored as expressed below and in conformance with regulations and rules therefore as required in the current manual of survey instructions of the United States Department of the Interior, Bureau of Land Management or by a decree of a court of law. Furthermore, that the corner points mentioned in lines 3, 4 and 5 above were, in a field survey on 3/1, 1982, found, recovered, restored, established or re-established as expressed below and in conformance with the rules of the Michigan State Board of Registration for Land Surveyors or, by a Decree of a Court of law:

A. Description of original monument and accessories and/or subsequent restoration:

B. Description of corner evidence found and/or method applied in restoring or re-establishing corner:

M-2 FD. 1/2" RE-ROD ON S. SIDE OF LARGE COR FN POST; FN'S E-W-N. THERE IS A WOODS LINE NORTH & COR FALLS NEAR SW COR OF CHERRY ORCHARD.

10 DROVE 5/8" X 36" RE-ROD FOR SW COR OF GOV'T. LOT 4 (S. 1/8 COR ON W LINE OF S-1); SINGLE PROPORTION TO U.S. (G.L.O.) BETW NW & SW COR'S. OF S-1.

* RE-ESTAB. U.S.M.C. ON LINE & AT SINGLE PROPORTION TO U.S.(G.L.O.) BETW THE NW & SW COR'S. OF SEC. 1.

C. Description of monument for corner and accessories established to perpetuate locating the position of the corner:

M-2	10	*
FD. 1/2" RE-ROD.	SET 5/8"X36" RE-ROD W/RLS	SET DNR MON & CED POST
19" MAPLE N80°W 158.52	CAP & CED POST W/LOC TAG.	9" HEMLOCK S40°W 28.5
17" MAPLE N10°W 78.50	9" CEDAR N55°E 24.6	8" W. PINE S05°W 12.9
	10" " N15°E 36.5	9" MAPLE S65°E 20.3
	12" MAPLE N20°W 19.5	WATERS EDGE(BASS LK) NORTH 15'±
		N-S RANDOM EAST 2'±


SIGNED BY Carl F. Roser DATE 02-03-82

SURVEYOR'S MICHIGAN REGISTRATION NO. 12028

FOR STATE AND UNITED STATES AGENCIES:

SIGNED BY _____ DATE _____

APPROVED AND SIGNED BY _____ DATE _____

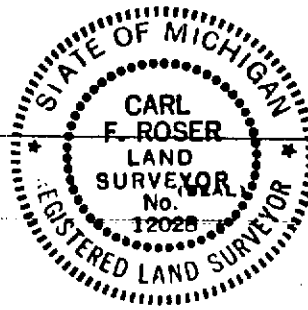

(SEAL)
GREEN LAKE TWP
GD. TRAVERSE COUNTY

SURVEYOR'S MICHIGAN REGISTRATION NO. _____