

LAND CORNER RECORDATION CERTIFICATE
 Filing Requirement of Act 74, Mich. PA 1970

STATE OF MICHIGAN
 GRAND TRAVERSE COUNTY
 RECORDED

30 DEC 99 3:51 P.M.

KARON ANDERSON
 REGISTER OF DEEDS

For Corners In: Grand Traverse Located In _____ Corner Code # _____
 (County)


1. Public Land Survey T 27N R 9W D-6
 T _____ R _____
 2. Property Controlling in Section S T _____ **SURVEY & REMONUMENTATION**
 S T _____ R _____
 3. Miscellaneous Property in Section S T _____ **MAR 22 2000**
 S T _____ R _____

Register of Deeds Stamp & File Number

4. Lot No: _____ Recorded Plat: _____ **SECTION**
 5. Private Claims: _____

I, Craig W. McVean, in a field survey on Oct. 19, 1999 do hereby state that under requirements of PA 74, Michigan PA of 1970, the corner points mentioned in lines 1 and 2 above were in conformance with regulations and rules therefore as required in the current manual of survey instructions of the United States Department of the Interior, Bureau of Land Management or by a decree of a Court of Law and/or that the corner points mentioned in lines 3, 4 and 5 above were in conformance with the rules of the Michigan Board of Land Surveyors or by a Decree of a Court of Law; established, re-established, monumented, recovered, found as expressed below:

NOTE: Not more than 2 corners, all in the same town and range, may be recorded on this certificate.

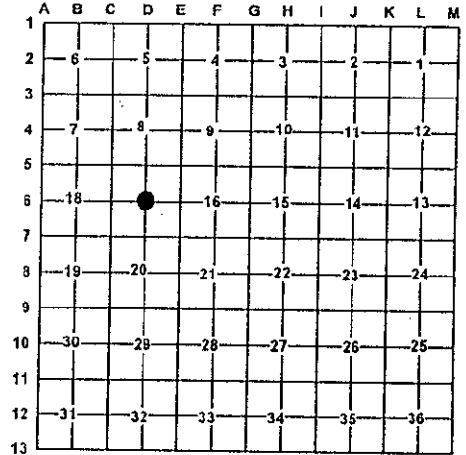

A. Description of original monument and accessories and/or subsequent restoration:

- D-6 - L.13, pg. 74 - E.H. Ailyn-1904
 Fnd old rotten stake put in its place a stone (14"X10"X10")
 With an 'X' Chiseled on top with stones around it.
- L.2, pg. 400 - E.P. Waterman -1910
 A large stone with 'X' on top set by E.H. Ailyn
- GTCRC wit. card - fnd. Stone with 'X' - 1967
 N26°W iron 80.91'
 N13°E iron 83.30'
 N58°E iron 90.92'
- Recorded survey L.3, pg.382 - W. Batzer -1977- fnd. ¼" iron pipe
 N25°W 80.82' 1" iron bar
 N15°E 83.18' 1" iron bar
 N60°E 90.82' 1" iron bar

B. Description of corner evidence found and/or method applies in restoring or re-establishing corner:

D-6 - Center ¼ section 17 - fnd. 1"X1.6" bent iron rod at surface - removed and dug down 2' and find 0.8'X0.8'X0.7' granite stone with 'X' on top with rail road spike on the West side and also surrounded by 5 other stones. Stone with 'X' was 0.04' N & 0.14'W of Surface iron. Stone in C/L of E-W gravel Rd. Stone with 'X' per Ailyn accepted as the best available evidence of the position of the corner.

C. Description of monument for corner and accessories established to perpetuate locating the position of the corner:

D.6 - Removed stone with 'X' and replaced with 3 ¼" "Grand Traverse County Remon." brass cap on 2 ½" X 30" galvanized iron pipe in ring of of stones - down 0.6'
 Inverted stone with 'X' & placed at base of pipe on N. side as memorial.
 South 33.00' to set 2" Alum. Cap on 5/8" x 34" rebar on line with blue carsonite post with location tag
 North 33.00' to set 2" Alum. Cap on 5/8" X34" rebar on line with blue carsonite post with location tag.
 N10°E 83.32' to fnd 1" iron rod (GTCRC, WB)
 N52°E 91.04' to fnd 1" iron rod (GTCRC, WB)
 S37°E 60.00' to set N&T in NE side 10' R. Pine scribed ' XBT'



Signed by: Craig W. McVean Date: 12/13/1999
 UNIMOUSLY BY THE BOARD OF PROFESSIONAL SURVEYORS
 GRAND TRAVERSE COUNTY PEER REVIEW GROUP AS THE OFFICIAL CORNER UNDER MICHIGAN PUBLIC ACT 345 OF 1990 AT A MEETING HELD ON 12/13/99
 39088