

LAND CORNER RECORDATION CERTIFICATE

Filing Requirement of Act 74, Mich. PA 1970

STATE OF MICHIGAN  
GRAND TRAVERSE COUNTY  
RECORDED


30 DEC 99 3:55 P.M.

KARON ANDERSON  
REGISTER OF DEEDS

Register of Deeds Stamp & File Number

For Corners In:  
Grand Traverse Located In Corner Code #  
(County)

- 1. Public Land Survey T 27N R 9W G-5  
T R
- 2. Property Controlling in Section S T R SURVEY & REMONUMENTATION  
S T
- 3. Miscellaneous Property in Section S T R  
S T R MAR 22 2000
- 4. Lot No: Recorded Plat: SECTION
- 5. Private Claims:

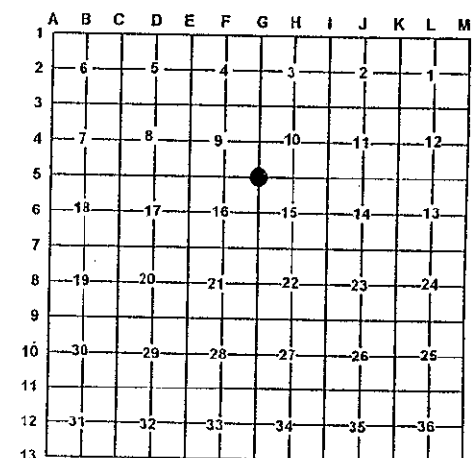

I, Craig W. McVean, in a field survey on Oct. 11, 1999 do hereby state that under requirements of PA 74, Michigan PA of 1970, the corner points mentioned in lines 1 and 2 above were in conformance with regulations and rules therefore as required in the current manual of survey instructions of the United States Department of the Interior, Bureau of Land Management or by a decree of a Court of Law and/or that the corner points mentioned in lines 3, 4 and 5 above were in conformance with the rules of the Michigan Board of Land Surveyors or by a Decree of a Court of Law; established, re-established, monumented, recovered, found as expressed below:

NOTE: Not more than 2 corners, all in the same town and range, may be recorded on this certificate.

A. Description of original monument and accessories and/or subsequent restoration:


- G-5 - 1850, GLO, - L. Lyon, set Cherry Post for section corner Hemlock 40" N72°E 45 links  
Cherry 6" S58°W 23 links
- 1907, E.P. Waterman, L.2, P.340 - Fnd. Stake and Stone correctly placed from one government witness yet in place.
- L.5, P.227-E.P. Waterman - stake & stone  
Maple 12" N20°W 14 links  
Beech 12" N39°E 46 links
- Consumer P.Co. - 1967 - P.Perla - Fnd. well pt.  
8" Maple N16°E 16.15'  
12' Maple S 59.5°E 48.20'  
6" Maple S4°E 28.71'
- Rec. Sur L.3, pg. 988 L. Czubak, well point fnd.  
8" Maple N16°E 16.15'  
12" Maple S 59.5°E 48.20'  
6" Maple S4°E 28.71'

B. Description of corner evidence found and/or method applies in restoring or re-establishing corner:

G-5 - Sec. Corner common to sec 9,10,15&16 - found 1 3/4" O.D. well point per Consumers Power Company & Czubak. Fits Waterman's survey in Sec 15. Dug around Well point to look for stone, found several small stones but nothing marked. Area in road cut E & W. Apparent secondary re-growth on Waterman's Maple wit. to the NW. Well point accepted as a careful & faithful perpetuation of the position of the original corner.

C. Description of monument for corner and accessories established to perpetuate locating the position of the corner:

- G-5 - Replaced 1 1/4" x 3' long well point with 3 1/4" 'Grand Traverse Co. Remon.' brass Cap on 2 1/2" X 30" Iron Pipe in a ring of stone - down 0.9'  
South 16.5' to set blue carsonite post with Location tag.  
N15°W 11.02' to set N&T in W. side 16" R. Maple (EPW)  
S59°E 48.09' to set N&T in S. side 23" Tw.R. Maple (CPC,LC)  
S6°E 28.76' to set N&T in W. side 12" S. Maple scribed 'XBT' (CPC,LC)  
S68°W 80.88' to set N&T in S. side 9" R.Pine scribed 'XBT'  
N15°E 25.28' to set N&T in E. side 19" R. Oak scribed 'XBT'

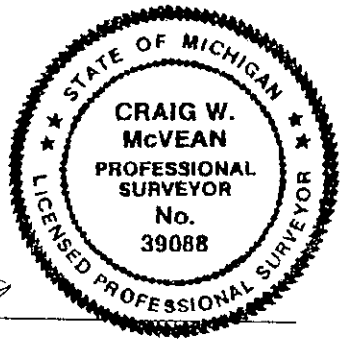

Signed by: Craig W. McVean  
Surveyor's Michigan License No.: 39088

Date: 12/13/1999

UNANIMOUSLY ACCEPTED BY THE GRAND TRAVERSE COUNTY PEER REVIEW GROUP AS THE OFFICIAL CORNER UNDER MICHIGAN PUBLIC ACT 345 OF 1990 AT A MEETING HELD ON 12/22/99

ROBERT F. MITCHELL, P.S., Chairman