

LAND CORNER RECORDATION CERTIFICATE

Filing Requirement of Act 74, Mich. PA 1970

For Corners In: Grand Traverse Located In Corner Code # (County)

1. Public Land Survey T 27N R 9W H5
2. Property Controlling in Section S T R
3. Miscellaneous Property in Section S T SURVEY & REMONUMENTATION S T MAR 22 2000

4. Lot No: Recorded Plat: SECTION

5. Private Claims: SECTION

I, Craig W. McVean, in a field survey on May 10, 1999 do hereby state that under requirements of PA 74, Michigan PA of 1970, the corner points mentioned in lines 1 and 2 above were in conformance with regulations and rules therefore as required in the current manual of survey instructions of the United States Department of the Interior, Bureau of Land Management or by a decree of a Court of Law and/or that the corner points mentioned in lines 3, 4 and 5 above were in conformance with the rules of the Michigan Board of Land Surveyors or by a Decree of a Court of Law; established, re-established, monumented, recovered, found as expressed below:

NOTE: Not more than 2 corners, all in the same town and range, may be recorded on this certificate.

A. Description of original monument and accessories and/or subsequent restoration:


- H5- 1850- L. Lyon, GLO, Set Beech Post Sugar 12" N70°E 20 Links Sugar 10" S53°W 36 Links
- L.1, pg. 28-29 - W. Slawson - 1874-Sec. 10 survey
- L.2, pg. 340 - 1907- E. P. Waterman- Fnd. Stone and 1/4 post Placed Stone with 'X' on top and added '1907' on S side of new stone. Placed new stone where old stake and small blue stone used to be.
- L.8, pg. 336 - C.O. Carver - 1930 - stone with 'X'
- 1967- P. Perla, Consumers Power Co. Stone with 'X' found. 20" Elm N20°31'W 83.85' 24" Maple N48°02'W 53.29' 6" Maple N76°52'W 69.50'
- LCRC L.3, pg.351- 1991- R. Mitchell- Found Stone with 'X' per Slawson, Waterman & Carver. S60°W 61.46' 6" Jack Pine S40°E 37.85' Power Pole N55°W 53.27' 36" Maple N82°W 42.30' Oak

B. Description of corner evidence found and/or method applies in restoring or re-establishing corner:

H5- 1/4 corner common to sections 10 and 15. - Found 1.2' X 0.7' X 1.0' Granite Stone with 'X' on top and '1907' on S. side with a ring of stone per LCRC. Stone in island of gravel & sand road 'T' intersection - N, S. & E. Stone with 'X' by Waterman at apparent Slawson perpetuation accepted as a careful & faithful perpetuation of the position of the original corner.

C. Description of monument for corner and accessories established to perpetuate locating the position of the corner:

H5- Replaced stone with 'X' with 3 1/4 " Grand Traverse Co. Remon.' brass cap on 2 1/2 " X 30 " galvanized iron pipe in a ring of stone Place stone with 'X' inverted at N. base of pipe as memorial. S36°E 37.85' to set N&T in SW side Power Pole (RM) South 32.98' to fnd. 1/2" Capped Iron Rod #23514 S7°W 34.02' to set N&T in E. side 6" R. Pine scribed 'XBT' S76°W 59.50' to set N&T in S. side 10" R. Oak scribed 'XBT' N80°W 42.30' to set N&T in N side 10" R. Oak (RM) N50°W 53.21' to set N&T in N side 26" S. Maple (CPC,RM)

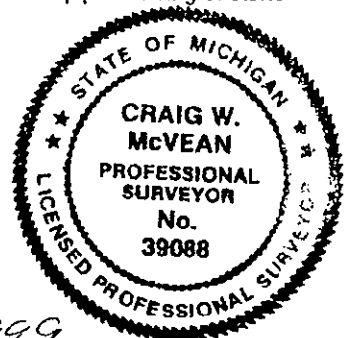

Signed by: Craig W. McVean Date: 12/13/1999

UNANIMOUSLY ACCEPTED BY THE GRAND TRAVERSE COUNTY PEER REVIEW GROUP AS THE OFFICIAL CORNER UNDER MICHIGAN PUBLIC ACT 345 OF 1990 AT A MEETING HELD ON 9/22/99

39088

ROBERT F. MITCHELL, P.S., Chairman