

LAND CORNER RECORDATION CERTIFICATE

Filing Requirement of Act 74, Mich. PA 1970

For Corners In: Grand Traverse (County)	Located In	Corner Code #	
1. Public Land Survey	T <u>27N</u> R <u>9W</u>	<u>J6</u>	
	T _____ R _____	_____	_____
2. Property Controlling in Section	S _____ T _____ R _____	_____	_____
	S _____ T _____ R _____	_____	_____
3. Miscellaneous Property in Section	S _____ T _____ R _____	_____	_____
	S _____ T _____ R _____	_____	_____


Register of Deeds Stamp & File Number

4. Lot No: _____ Recorded Plat: _____

5. Private Claims: _____

I, Craig W. McVean, in a field survey on December 2, 1999 do hereby state that under requirements of PA 74, Michigan PA of 1970, the corner points mentioned in lines 1 and 2 above were in conformance with regulations and rules therefore as required in the current manual of survey instructions of the United States Department of the Interior, Bureau of Land Management or by a decree of a Court of Law and/or that the corner points mentioned in lines 3, 4 and 5 above were in conformance with the rules of the Michigan Board of Land Surveyors or by a Decree of a Court of Law; established, re-established, monumented, recovered, found as expressed below:

NOTE: Not more than 2 corners, all in the same town and range, may be recorded on this certificate.

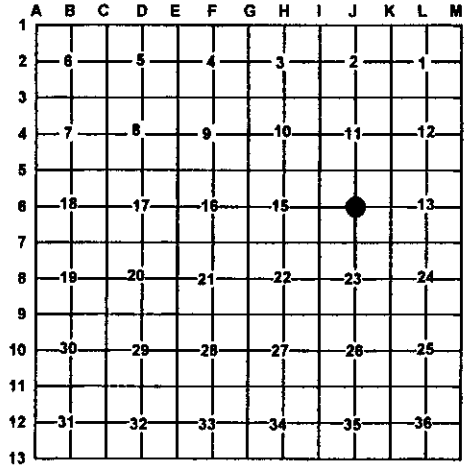

A. Description of original monument and accessories and/or subsequent restoration:
J6- L.1, P.26-27 – Wm. Slawson – 1876
 Sugar 40° N13°E 53
 B. Oak 16° N67°W 52

B. Description of corner evidence found and/or method applies in restoring or re-establishing corner:
J6- C ¼ Sec. 14 – Searched for evidence of Slawson's corner but could find nothing. Set 3 ¼" 'Grand Trav. Co. Remon.' Brass Cap on 2 ½" x 30" Galv. Iron pipe at the intersection of ¼ lines per standard BLM procedure. Position is 6' N of CL of E-W Meandering Sand Rd. 3 ¼" Brass Cap accepted as the best available evidence of the position of the corner.

C. Description of monument for corner and accessories established to perpetuate locating the position of the corner:
J6- 3 ¼" 'Grand Traverse County Remon.' Brass Cap on 2 ½" x 30" Galv. Iron pipe in ring of stone – down 0.8' – on N. Edge of E-W Sand Rd.
 Set Blue Carsonite Post w/ Loc. Tag 33' S
 N30°E 17.66' to set N & T in W side of 5" R. Pine
 N47°W 43.73' to set N & T in SW side of 8" R. Oak
 S25°E 42.79' to set N & T in NE side of 12" S. Maple scribed 'XBT'
 S60°W 50.65' to set N & T in SE side 12" R. Oak scribed 'XBT'



Signed by: Craig W. McVean
 Surveyor's Michigan License No.: 39088

Date: 12/13/1999