

LAND CORNER RECORDATION CERTIFICATE

Filing Requirement of Act 74, Mich. PA 1970

For Corners In: Grand Traverse (County)	Located In	Corner Code #
1. Public Land Survey	T <u>27N</u> R <u>9W</u>	<u>H6</u>
	T _____ R _____	_____
2. Property Controlling in Section	S _____ T _____ R _____	_____
	S _____ T _____ R _____	_____
3. Miscellaneous Property in Section	S _____ T _____ R _____	_____
	S _____ T _____ R _____	_____


4. Lot No: _____ Recorded Plat: _____

5. Private Claims: _____

I, Craig W. McVean, in a field survey on December 1, 1999 do hereby state that under requirements of PA 74, Michigan PA of 1970, the corner points mentioned in lines 1 and 2 above were in conformance with regulations and rules therefore as required in the current manual of survey instructions of the United States Department of the Interior, Bureau of Land Management or by a decree of a Court of Law and/or that the corner points mentioned in lines 3, 4 and 5 above were in conformance with the rules of the Michigan Board of Land Surveyors or by a Decree of a Court of Law; established, re-established, monumented, recovered, found as expressed below:

NOTE: Not more than 2 corners, all in the same town and range, may be recorded on this certificate.

Register of Deeds Stamp & File Number

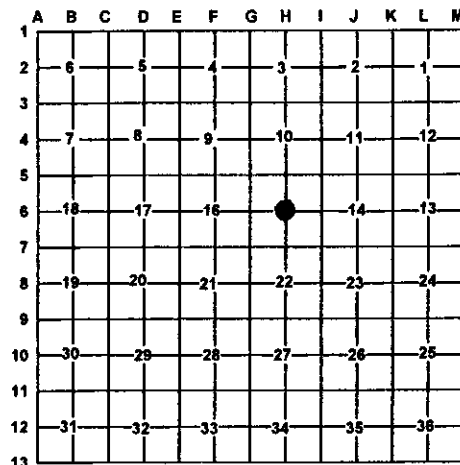

A. Description of original monument and accessories and/or subsequent restoration:
H6- L.2, P.290-291 – E.P. Waterman – 1908
 Set approximate stake

B. Description of corner evidence found and/or method applies in restoring or re-establishing corner:
H6- C ¼ Sec. 15 – Could find no evidence of Waterman's approx. stake. Waterman's position would not have been acceptable since he only ran the E ½ of E-W ¼ line. Waterman never located the W ¼ cor of Sec. 15. Set 3 ¼" 'Grand Trav. Co. Remon.' Brass Cap on 2 ½" x 30" Galv. Iron pipe at the intersection of ¼ lines per standard BLM procedure. 3 ¼" Brass Cap accepted as the best available evidence of the position of the corner.

C. Description of monument for corner and accessories established to perpetuate locating the position of the corner:
H6- 3 ¼" 'Grand Traverse Co. Remon.' Brass Cap on 2 ½" x 30" Galv. Iron pipe in ring of stone.
 SW 1' to set Blue Carsonite Post
 N53°E 32.69' to set N & T in NW side of 21" R. Oak scribed 'XBT'
 S40°E 42.96' to set N & T in SW side of 24" R. Oak scribed 'XBT'
 S24°W 34.29' to set N & T in E side of 12" Basswood scribed 'XBT'
 N51°W 20.77' to set N & T in NE side 13" S. Maple scribed 'XBT'



Signed by: Craig W. McVean Date: 12/13/1999
 Surveyor's Michigan License No.: 39088