


# LAND CORNER RECORDATION CERTIFICATE

Filing Requirement of Act 74, Mich. PA 1970

For Corners In: Grand Traverse (County)	Located In	Corner Code #
1. Public Land Survey	T <u>27N</u> R <u>9W</u>	<u>G-10</u>
	T _____ R _____	_____
2. Property Controlling in Section	S _____ T _____ R _____	_____
	S _____ T _____ R _____	_____
3. Miscellaneous Property in Section	S _____ T _____ R _____	_____
	S _____ T _____ R _____	_____

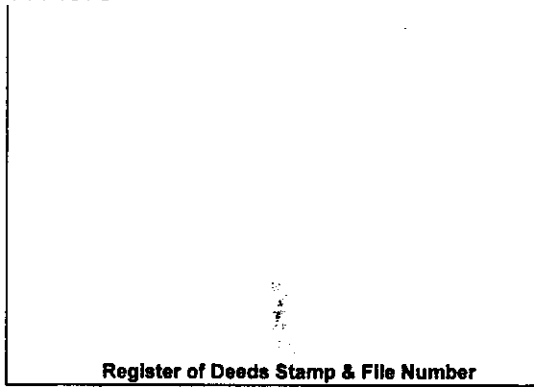

Register of Deeds Stamp & File Number

4. Lot No: \_\_\_\_\_ Recorded Plat: \_\_\_\_\_

5. Private Claims: \_\_\_\_\_

I, Craig W. McVean, in a field survey on Nov. 11, 1999 do hereby state that under requirements of PA 74, Michigan PA of 1970, the corner points mentioned in lines 1 and 2 above were in conformance with regulations and rules therefore as required in the current manual of survey instructions of the United States Department of the Interior, Bureau of Land Management or by a decree of a Court of Law and/or that the corner points mentioned in lines 3, 4 and 5 above were in conformance with the rules of the Michigan Board of Land Surveyors or by a Decree of a Court of Law; established, re-established, monumented, recovered, found as expressed below:

**NOTE: Not more than 2 corners, all in the same town and range, may be recorded on this certificate.**

	A	B	C	D	E	F	G	H	I	J	K	L	M
1													
2	6	5	4	3	2	1							
3													
4	7	8	9	10	11	12							
5													
6	18	17	16	15	14	13							
7													
8	19	20	21	22	23	24							
9													
10	30	29	28	27	26	25							
11													
12	31	32	33	34	35	36							
13													

**A. Description of original monument and accessories and/or subsequent restoration:**

- G-10- GLO- L. Lyon - set 1/4 post - 1850
  - W. Oak 6" N22°W 9 L.
  - W. Pine 8" S69°E 39 L.
- M. Schaaf- 1935 +/-, Set by measurement per index

**B. Description of corner evidence found and/or method applies in restoring or re-establishing corner:**

- G-10- 1/4 corner common to Sections 27 and 28, T27N, R9W. Found 1 1/4" iron pipe stub in concrete tablet base per M. Schaaf. CL of N-S firelane is 2.5' W. Monument is within 9' of single proportion position. Schaaf monument accepted as the best available evidence of the position of the original corner

**C. Description of monument for corner and accessories established to perpetuate locating the position of the corner:**

- G-10 - Replaced Schaaf Mon. with 3 1/4" 'Grand Traverse County Remon.' Brass cap on a 2 1/2" X 30" Galvanized iron pipe. Set 0.6' down with pieces of concrete around.
  - \*S62°W 20.76' to set N&T in SE. side of 14" R. Oak
  - \*N10°W 64.47' to set N&T in East side of 20" R. Oak
  - N41°E 32.10' to set N&T in SE side of 4" R. Pine scribed 'XBT'
  - S84°E 46.40' to N&T in N. side 9" W. Pine scribed 'XBT'
  - S12°E 42.95' to N&T in W. side 13" Tw. R. Oak scribed 'XBT'
  - West 33' to set Blue Carsonite post with location tag

\* Old blazes & nails set by others



Signed by: Craig W. McVean

Date: 12/13/1999

Surveyor's Michigan License No.: 39088