

LAND CORNER RECORDATION CERTIFICATE


Filing Requirement of Act 74, Mich. PA 1970

For Corners In: <u>Grand Traverse</u> (County)	Located In _____	Corner Code # _____	
1. Public Land Survey	T _____ R _____	_____	_____
2. Property Controlling in Section	S 15 T 27N R 9W	9	_____
	S 15 T 27N R 9W	12	_____
3. Miscellaneous Property in Section	S _____ T _____ R _____	_____	_____
	S _____ T _____ R _____	_____	_____
4. Lot No: _____	Recorded Plat: _____		
5. Private Claims: _____			

Register of Deeds Stamp & File Number

I, Craig W. McVean, in a field survey on May 22, 2000 do hereby state that under requirements of PA 74, Michigan PA of 1970, the corner points mentioned in lines 1 and 2 above were in conformance with regulations and rules therefore as required in the current manual of survey instructions of the United States Department of the Interior, Bureau of Land Management or by a decree of a Court of Law and/or that the corner points mentioned in lines 3, 4 and 5 above were in conformance with the rules of the Michigan Board of Land Surveyors or by a Decree of a Court of Law; established, re-established, monumented, recovered, found as expressed below:

NOTE: Not more than 2 corners, all in the same town and range, may be recorded on this certificate.

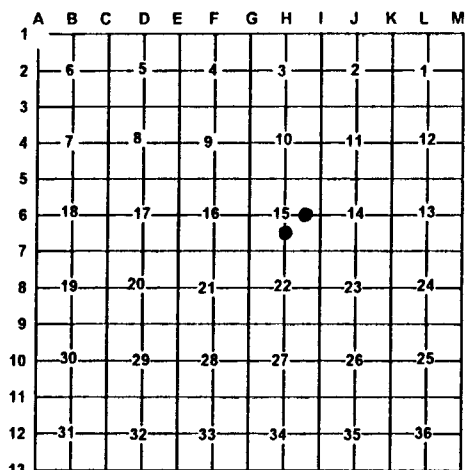

A. Description of original monument and accessories and/or subsequent restoration:

- | | |
|---|---|
| 9 - CSR- L. 2, P. 290-291 - E.P. Waterman-1908 - Set approx. stake. | 12 - CSR- L. 2, P. 290-291 - E.P. Waterman-1908 - Set approx. stake.
-Rec. Survey- L.8, P. 450-J. Gavin- iron set - 1997 |
|---|---|

B. Description of corner evidence found and/or method applies in restoring or re-establishing corner:

- | | |
|---|--|
| 9 - CE 1/16, Sec. 15, T27N, R9W
Set 2" Alum. Cap on 5/8" x 34" Rebar per Standard BLM Procedure. CL of N-S 2-track is 26' E. | 12 - CS 1/16, Sec. 15, T27N, R9W
Set 2" Alum. cap on 5/8" x 34" Rebar per Standard BLM Procedure.
-Reference Pt.- Fd. 1/2" CIR #25875/21568 per rec. survey- S65° 12'E 2.00' of '12'. This CIR is apparently based on a rejected R.F. Mitchell position at 'H7'. 1/2" CIR not utilized as '12' in this survey. |
|---|--|

C. Description of monument for corner and accessories established to perpetuate locating the position of the corner:

- | | |
|---|--|
| 9 - 2" AC on 5/8" x 34" Rebar in ring of stone.
S74°E 47.58' to set N&T in N. side 12" R. Pine
N23°W 10.38' to set N&T in W. side 16" S. Maple
S53°W 41.27' to set N&T in NW side 14" W. Pine
S25°W 26.60' to set N&T in E. side 7" B. Ash
Set Blue Carsonite Post w/ loc. tag 1' SE | 12 - 2" AC on 5/8" x 34" Rebar
N17°E 16.79' to N&T in W. side 10" Beech
N70°W 11.97' to N&T in S. side 2" W. Pine
S16°E 3.78' to N&T in E. side Twin 8" S. Maple
S80°E 27.65' to N&T in S. side 3" W. Pine
S65°12'E 2.00' to 1/2" CIR# 25875/21568- Ref. pt.
Set Blue Carsonite Post w/ loc. tag 1' NE |
|---|--|

Signed by: Craig W. McVean
 Surveyor's Michigan License No.: 39088

Date: 1/22/2001

