

LAND CORNER RECORDATION CERTIFICATE


Filing Requirement of Act 74, Mich. PA 1970

For Corners In: Grand Traverse (County)	Located In	Corner Code #	
1. Public Land Survey	T _____ R _____		
2. Property Controlling in Section	S 9 & 10 T 27N R 9W	SN 1/64	
	S 10 T 27N R 9W	CSNW 1/64	
3. Miscellaneous Property in Section	S _____ T _____ R _____		
	S _____ T _____ R _____		
4. Lot No: _____	Recorded Plat: _____		
5. Private Claims: _____			

Register of Deeds Stamp & File Number

I, Craig W. McVean, in a field survey on May 10, 2000 do hereby state that under requirements of PA 74, Michigan PA of 1970, the corner points mentioned in lines 1 and 2 above were in conformance with regulations and rules therefore as required in the current manual of survey instructions of the United States Department of the Interior, Bureau of Land Management or by a decree of a Court of Law and/or that the corner points mentioned in lines 3, 4 and 5 above were in conformance with the rules of the Michigan Board of Land Surveyors or by a Decree of a Court of Law; established, re-established, monumented, recovered, found as expressed below:

NOTE: Not more than 2 corners, all in the same town and range, may be recorded on this certificate.

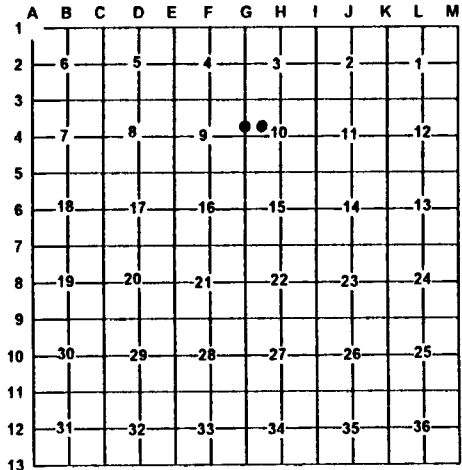

A. Description of original monument and accessories and/or subsequent restoration:

SN 1/64 – Unrec. Sur. – Mitchell & Associates file # 951448 – 1996 iron set CSNW 1/64 – Unrec. Sur. – Mitchell & Associates file # 951448 – 1996 iron set

B. Description of corner evidence found and/or method applies in restoring or re-establishing corner:

<p><u>SN 1/64</u> common to Sec. 9 & 10 and being the NW Cor of S ½ of SW ¼ of NW ¼, Sec. 10 T27N, R9W-Fnd. RFM ½" Capped Rebar. ½" CIR accepted as the best available evidence of the position of the corner.</p>	<p><u>CSNW 1/64</u> - NE Cor. of S ½ of SW ¼ of NW ¼ Sec. 10, T27N, R9W Fnd. ½" x 18" Capped Iron Rebar # 28417/30079. N-S 2-track is 90'+/- E. ½" CIR accepted as the best available evidence of the position of the corner.</p>
--	---

C. Description of monument for corner and accessories established to perpetuate locating the position of the corner:

<p><u>SN 1/64</u> - 1/2" x 18" CIR replaced w/ 2" Alum. Cap on 5/8" x 34" Rebar. N86°E 13.71' to N&T in S. side 7" R. Maple S50°E 15.25' to N&T in NE side 10" R. Oak N38°E 32.65' to N&T in SE side 10" S. Maple W'ly 50' to CL sand rd. Set Blue Carsonite Post with location tag 1' SE</p>	<p><u>CSNW 1/64</u> - Replace 1/2" x 18" CIR w/ 2" Alum. Cap on 5/8" x 34" Rebar N60°W 9.94' to N&T in SW side 3" Ironwood S48°W 24.78' to N&T in NW side 5" W. Pine S5°E 10.12' to N&T in W. side 5" J. Pine N41°E 29.15' to N&T in NW side 8" R. Maple Set Blue Carsonite Post with location tag 1' SE</p>
---	--

Signed by: Craig W. McVean
Surveyor's Michigan License No.: 39088

Date: 1/22/2001

