

Form 500 - Conserving

MICHIGAN
DEPARTMENT OF CONSERVATION
FORESTRY DIVISION

LAND CORNER RECORD

T. 27 N.R. 9 W


GRAND TRAVERSE COUNTY

DESCRIPTION OF CORNER SECTION CORNER COMMON TO SECTIONS 28-29-32-33

CORNER MONUMENT SET CONS. DEPT. MONUMENT BELOW SURFACE

DATE MONUMENT PLACED AND WITNESSED 6/25/68

WITNESSES TO CORNER.....

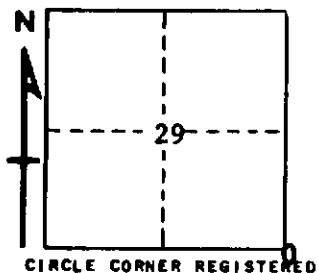

6" J. PINE S 35 E 17.6'

8" W. OAK S 75 W 16.4'

AND

6" W. OAK N 51 E 53.5'

DESCRIPTION IN DETAIL AS TO HOW CORNER WAS LOCATED AND IDENTIFIED OR RESTORED.

THIS CORNER WAS FOUND DURING RETRACEMENT IN THIS AREA. FOUND PLANTING BAR BURIED AT CORNER, PROBABLY AS ESTABLISHED IN 1934 SCHAAF SURVEY. USED IN MORE RECENT SURVEY. STUMP REMAINS FOR POSSIBLE NW U.S.B.T. IN PLACE.

SURVEYOR'S SEAL

SIGNED *Kenneth J. Ostberg* DATE 6/28/68
REGISTERED LAND SURVEYOR #10068